
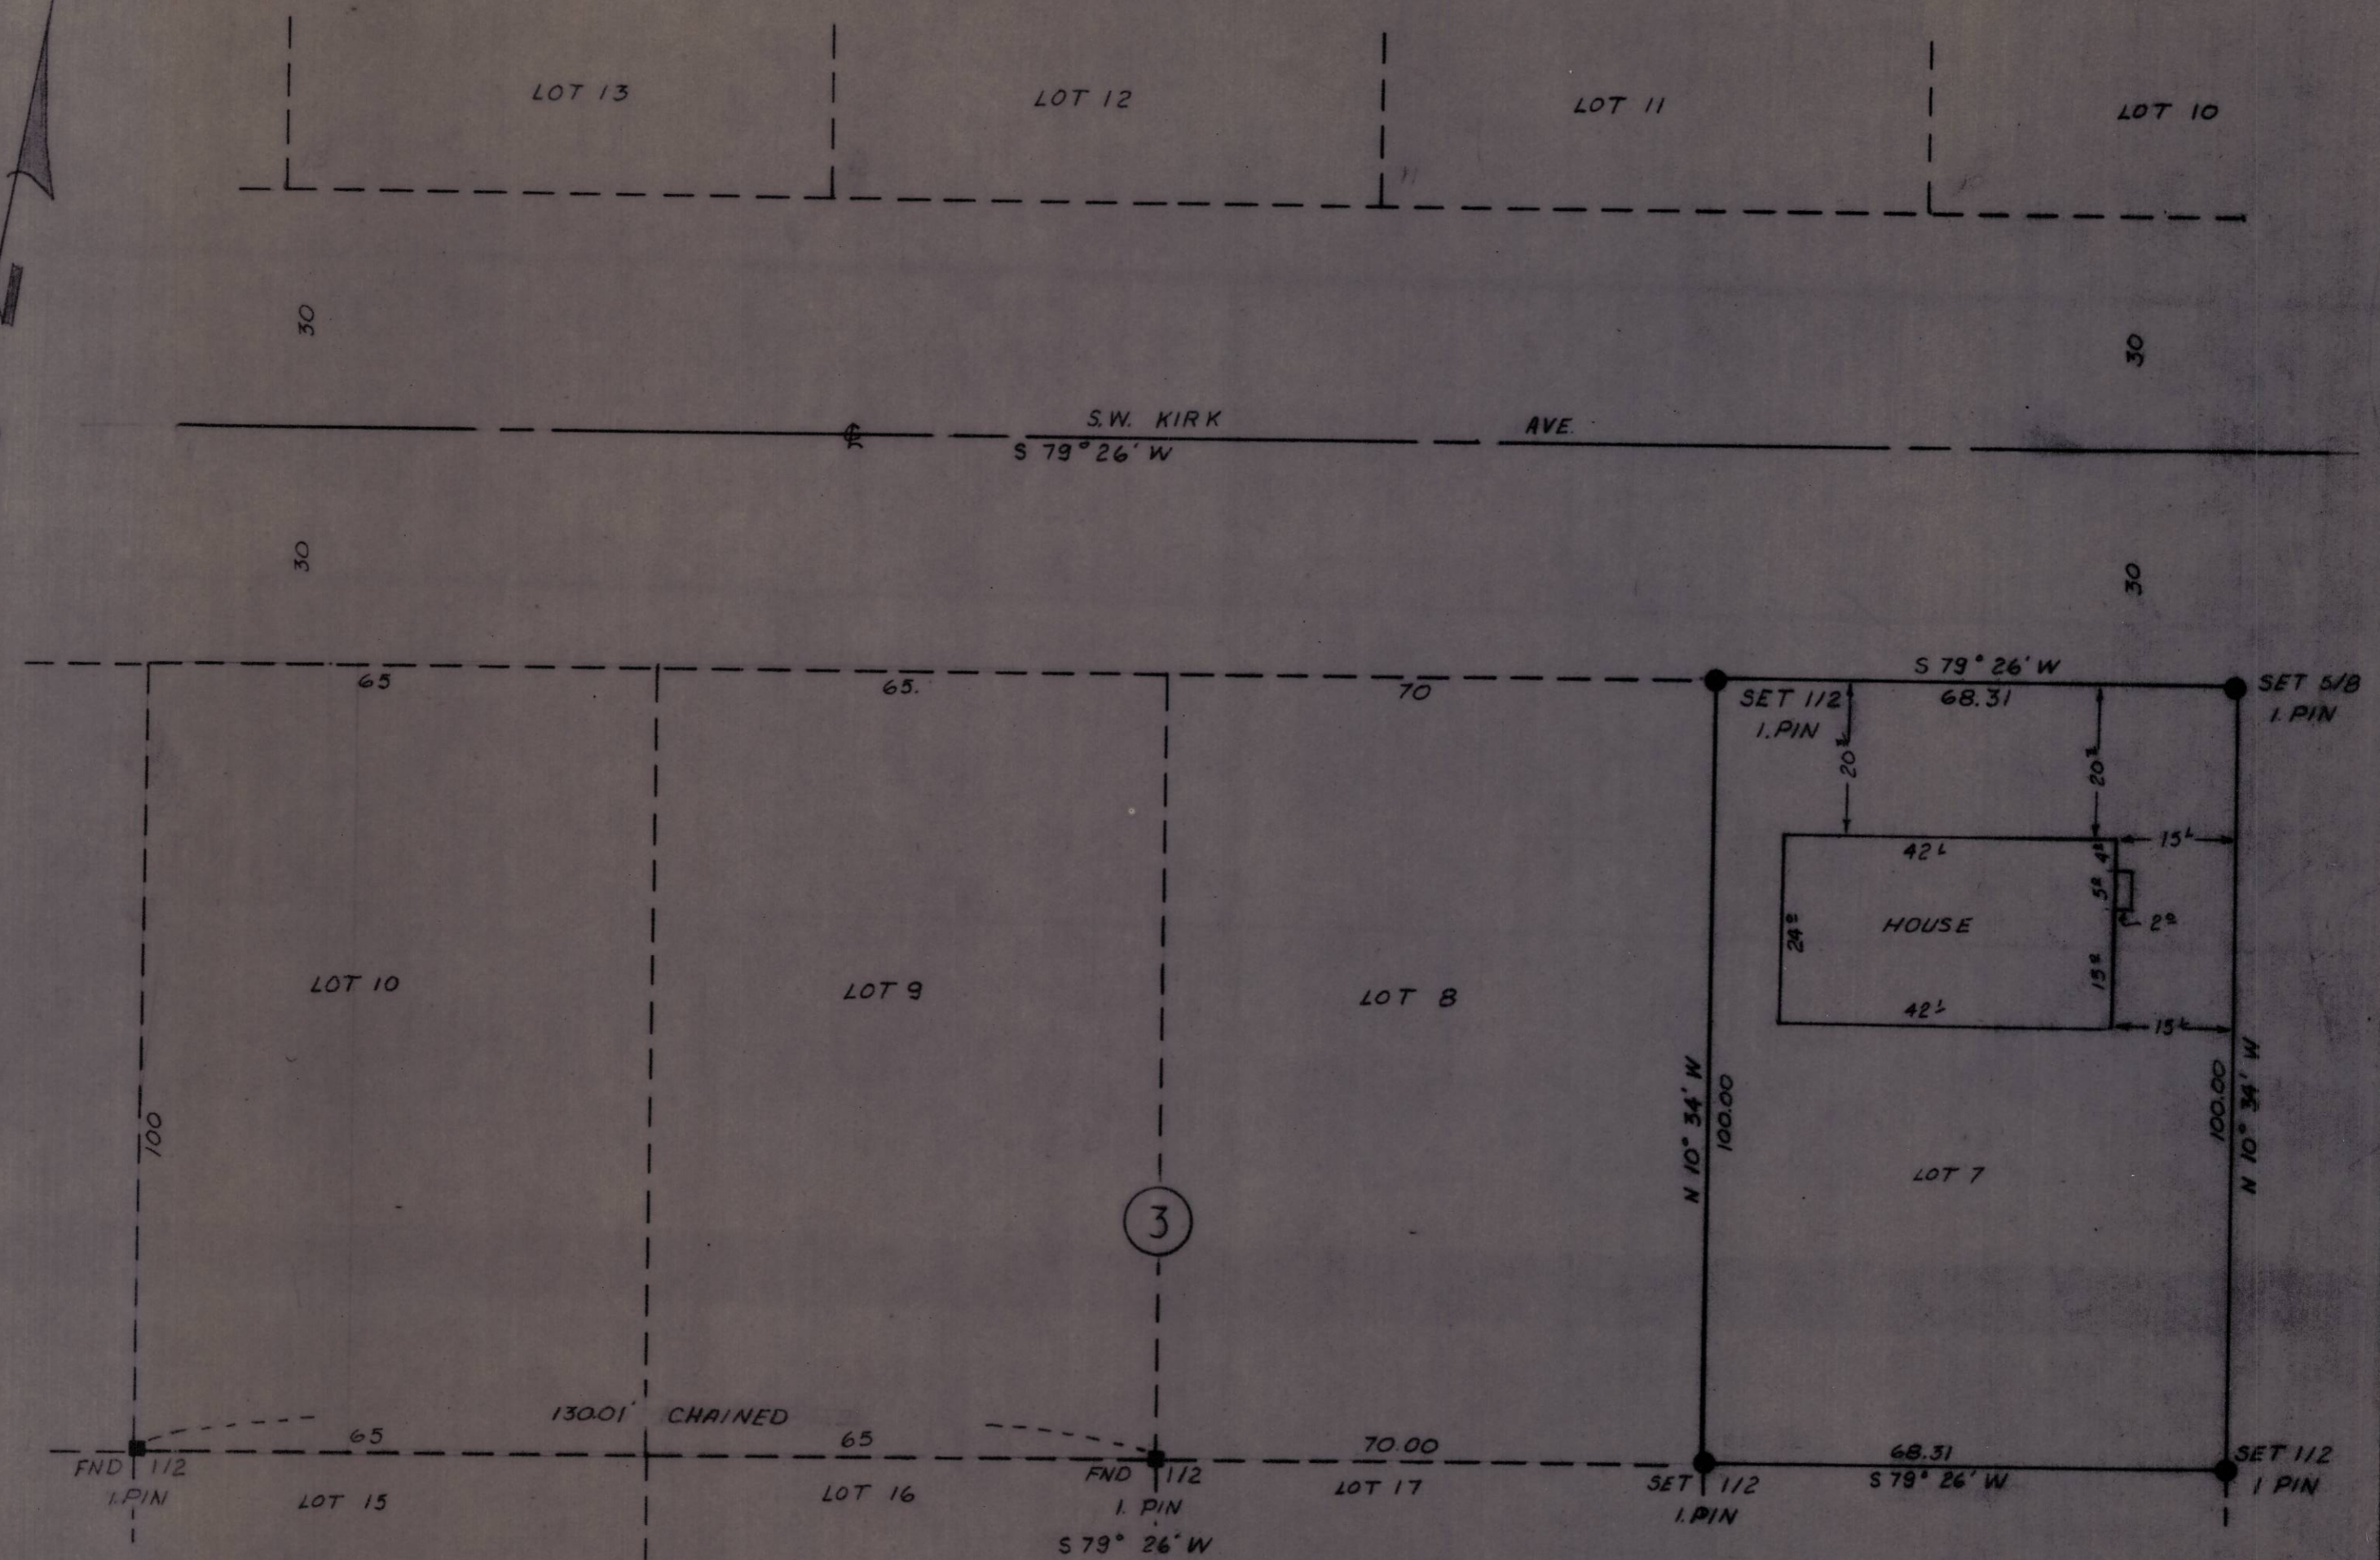


K-66

2

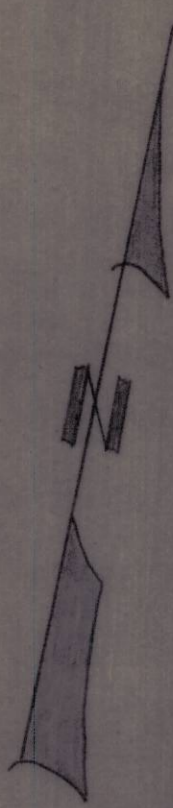

NOTE: BEARINGS ARE PLAT BEARINGS.

REGISTERED PROFESSIONAL LAND SURVEYOR

DAVID H. KRUMBEIN
OREGON
JULY 17, 1970
933

KRUMBEIN ENGINEERING CO. ENGINEERS - SURVEYORS - PLANNERS 216 S.E. 1st, Pendleton, Oregon	SCALE 1" = 20'
	DATE 11 DEC 75
	DRAWN BY T.H.
	CHKD. BY D.H.K.
SURVEY FOR FIRST FEDERAL SAVINGS AND LOAN LOT 7, BLOCK 3 PARKVIEW ADD TO THE CITY OF PENDLETON, OREGON	
DRNG. NO. 75-13B	

K-66