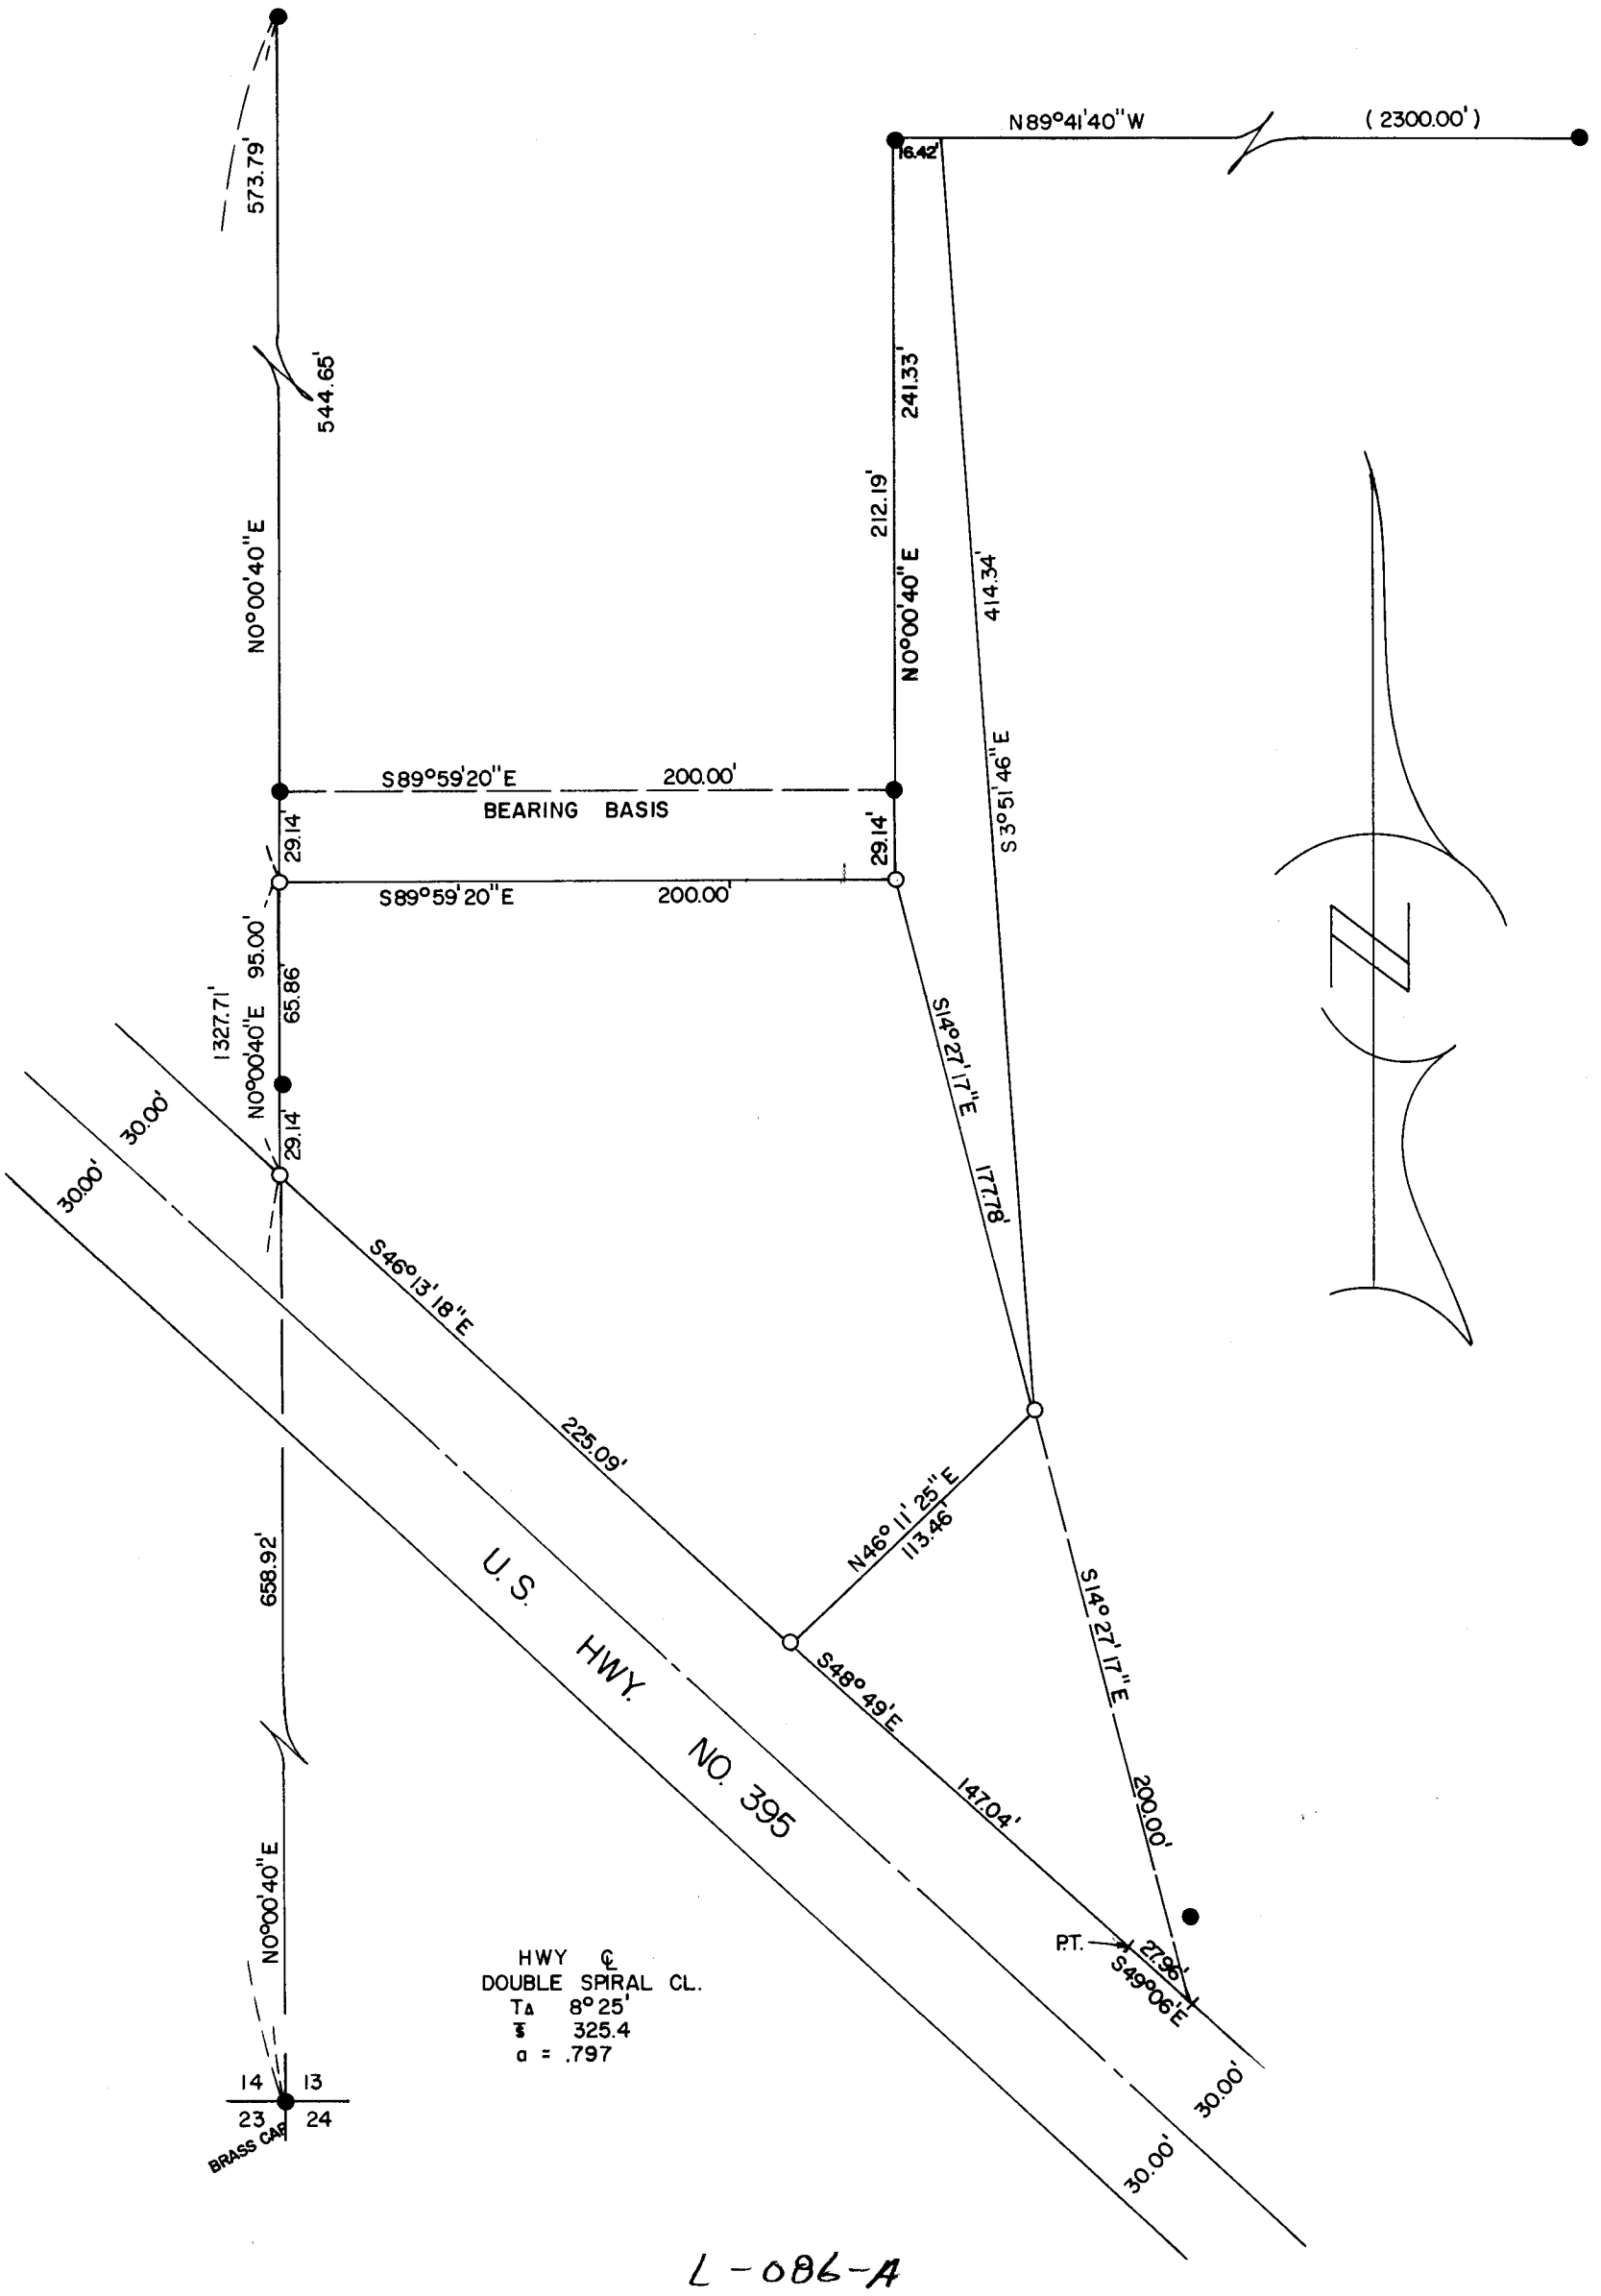

L-086-A

NOTE THIS SURVEY REVISES SURVEY #S7602022 DONE FEB. 28,1976 BY G. DENNIS EDWARDS.

REGISTERED PROFESSIONAL LAND SURVEYOR
G. Dennis Edwards
OREGON
JULY 16, 1971
G. DENNIS EDWARDS
951

SURVEY FOR: CECIL THOMPSON

LOCATION: SW 1/4 OF SEC. 13, T4N, R28E, W.M., UMATILLA COUNTY, OREGON

DATE: 10-14-76 SCALE: 1" = 60'

● 1/2" IRON RODS FOUND (000) OF RECORD

o 1/2" IRON RODS SET JOB NO. S7602022R

EDWARDS SURVEYING
567-3336
P. O. BOX 763
HERMISTON, ORE.