Q-12-A

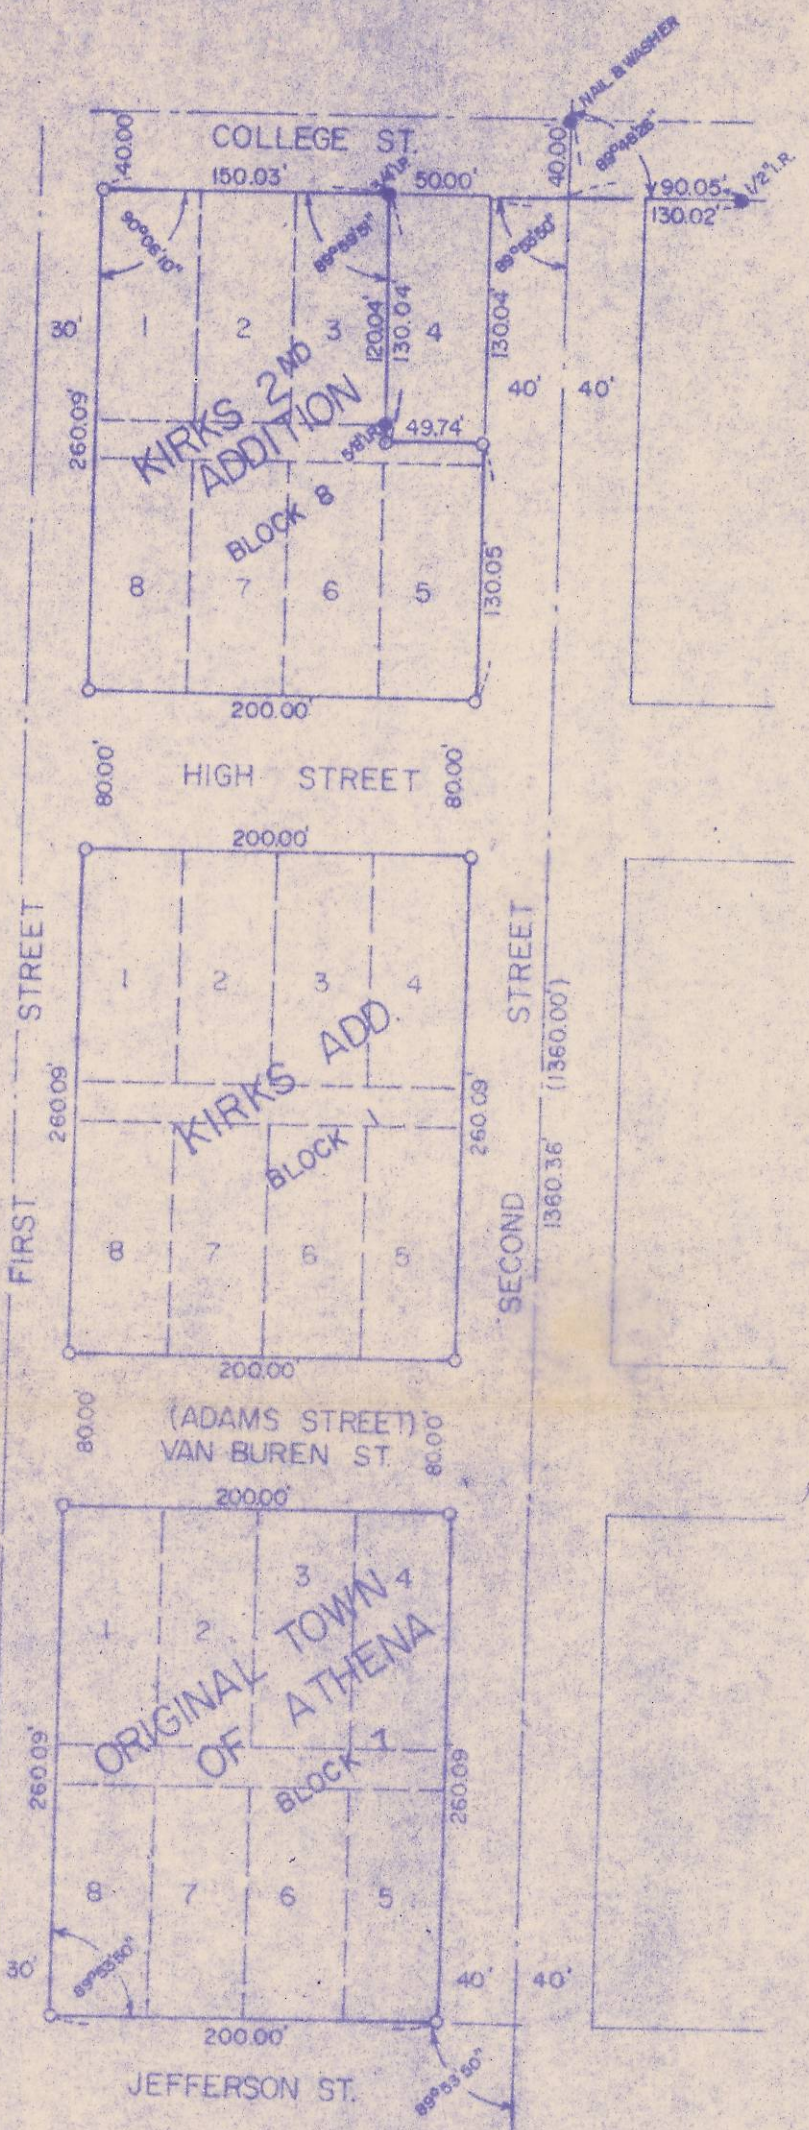


REGISTERED PROFESSIONAL LAND SURVEYOR

G. Dennis Edwards

OREGON
JULY 10, 1974
G. DENNIS EDWARDS
951

19BC

SURVEY FOR: UMATILLA COUNTY HOUSING AUTHORITY

LOCATION: IN THE NW 1/4 OF SECTION 19, T4N, R35E, W.M.
CITY OF ATHENA, UMATILLA COUNTY, OREGON

DATE: 10-4-78 SCALE: 1" = 100'

● MONUMENTS FOUND (000) OF RECORD

○ 1/2" IRON RODS SET JOB NO. S7809352

EDWARDS SURVEYING
567-3336
P.O. BOX 763
HERMISTON, OREGON