


Q-99-A

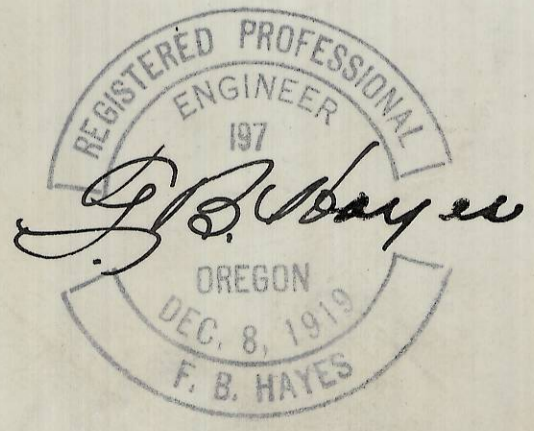

2N32 2DD

Q-99-A

HAYES & HARRIS ENGINEERING		
SURVEY FOR MARY JOHNSON		
WEST HALF OF BLK. 141 & LOTS 8 9, BLK. 142 RESERVATION ADD'N. PENDLETON, ORE.		
SCALE 1"=100'	DATE 2-17-55	DRAWN BY W. O. H.