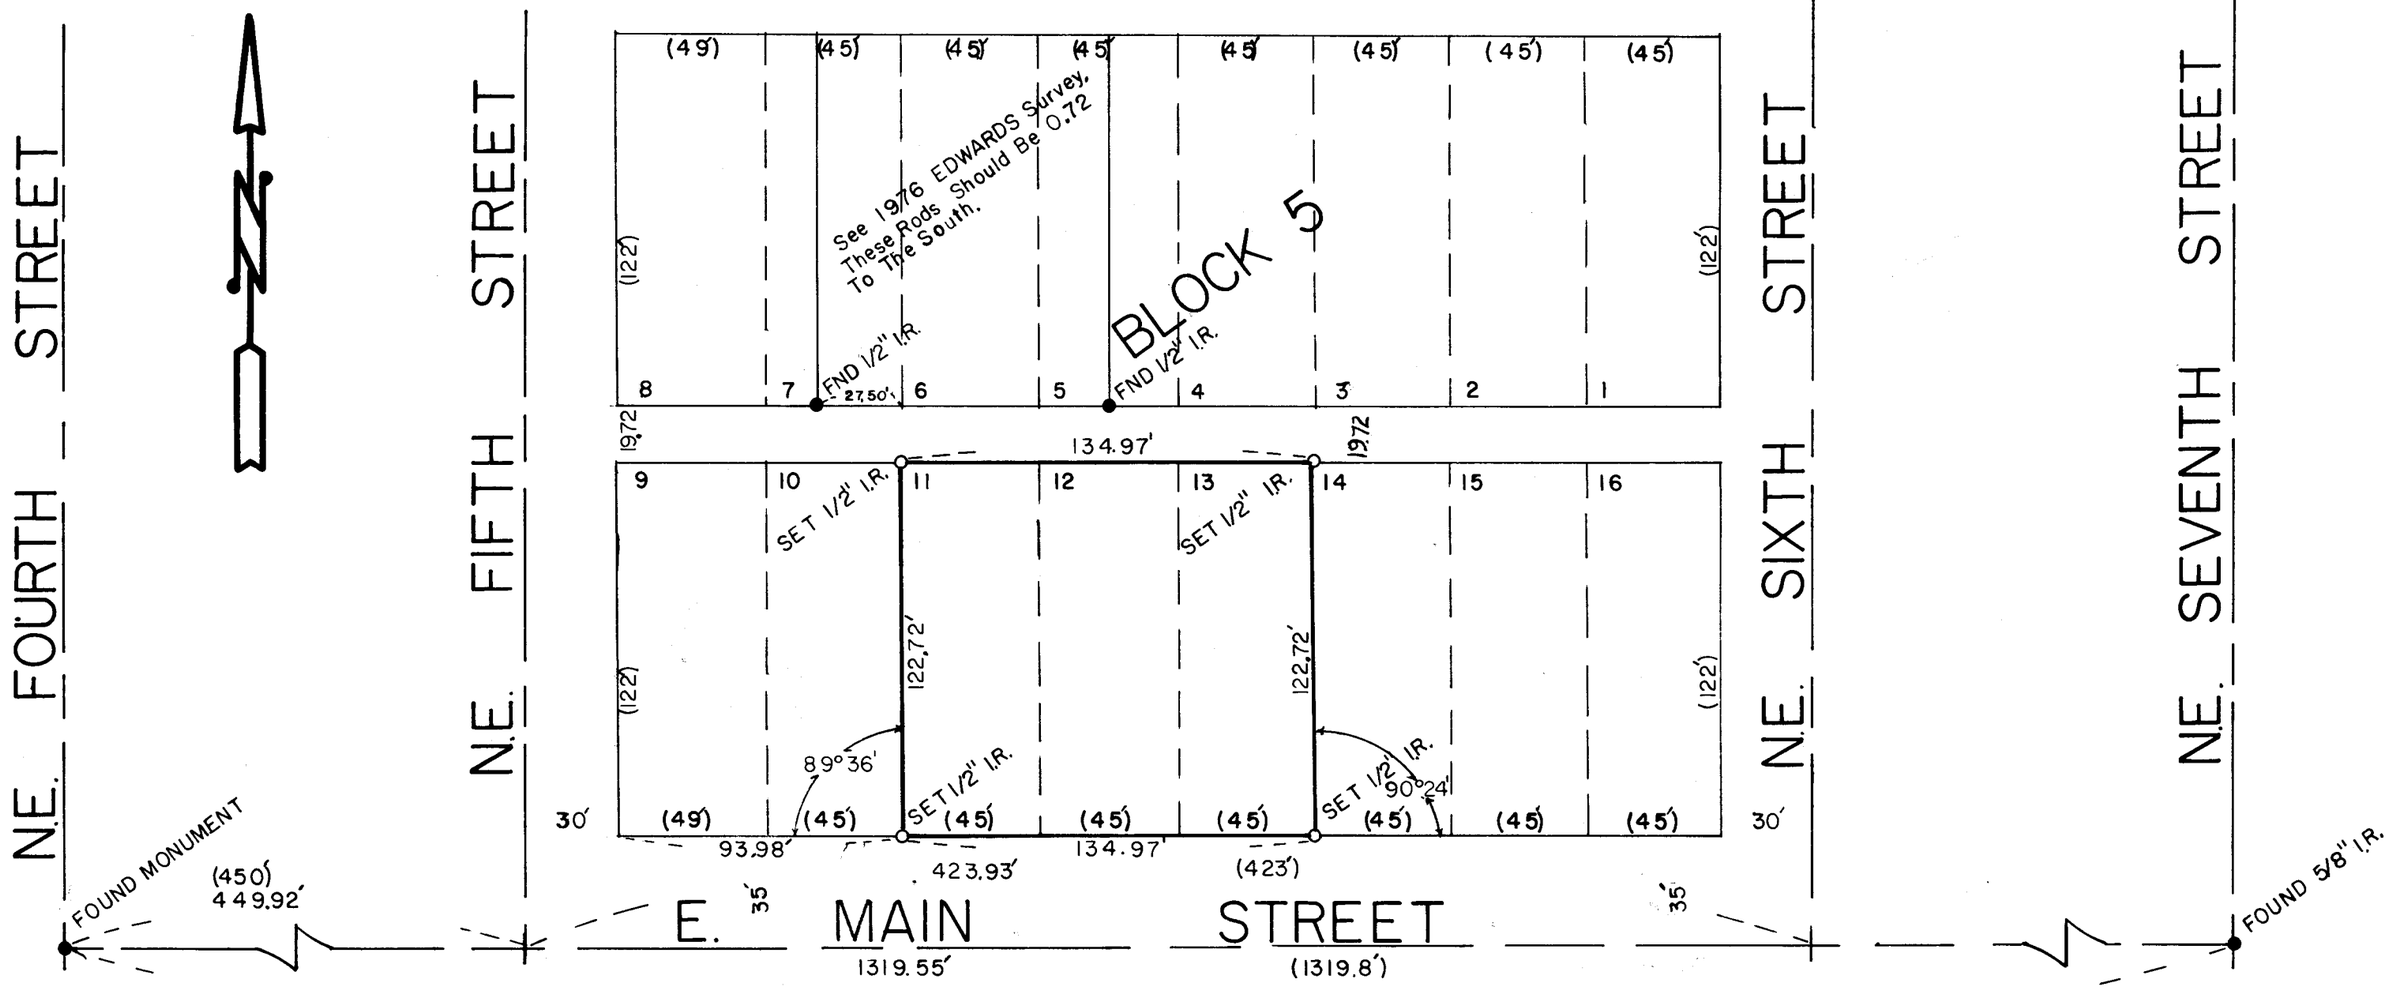

SURVEY FOR ROY POWELL

LOCATION BLOCK 5, NEWPORT ADD. S.W. 1/4
in the CITY of HERMISTON
SEC, 11 , T 4 N, R 28 E, W.M., UMATILLA COUNTY, OREGON

DATE 12-18-1978 SCALE: 1" = 50'

● MONUMENTS FOUND (000) OF RECORD

o IRON RODS SET JOB NO. S 7811411

EDWARDS SURVEYING
567-3336

P. O. Box 763
Hermiston, Ore.

Q-0120-A

REGISTERED
PROFESSIONAL
LAND SURVEYOR

G. Dennis Edwards

OREGON
JULY 16, 1971
G. DENNIS EDWARDS
951