

NE 1/4 NW 1/4

NW 1/4 NE 1/4


NE 1/4 NE 1/4

SE 1/4 NW 1/4


SW 1/4 NE 1/4

SE 1/4 NE 1/4

PLAT OF SURVEY
FOR
L.L. ROGERS
LOCATION OF DEEP WELL
AND LAND TO BE IRRIGATED
LOCATED IN SECTION II, T. 3 N.,
R. 34 E.W.M.
Scale 1" = 200'

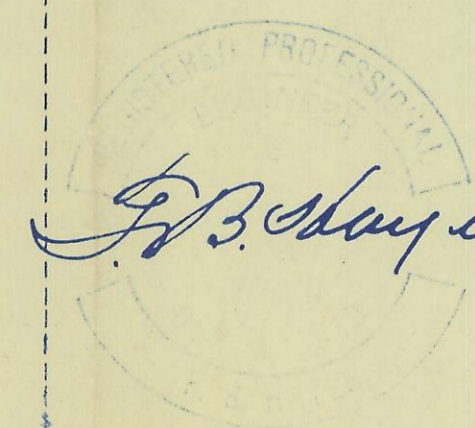

NOTE
THE PIPE LINE SHOWN ON THIS
PLAT IS STEEL, 4" DIAMETER.

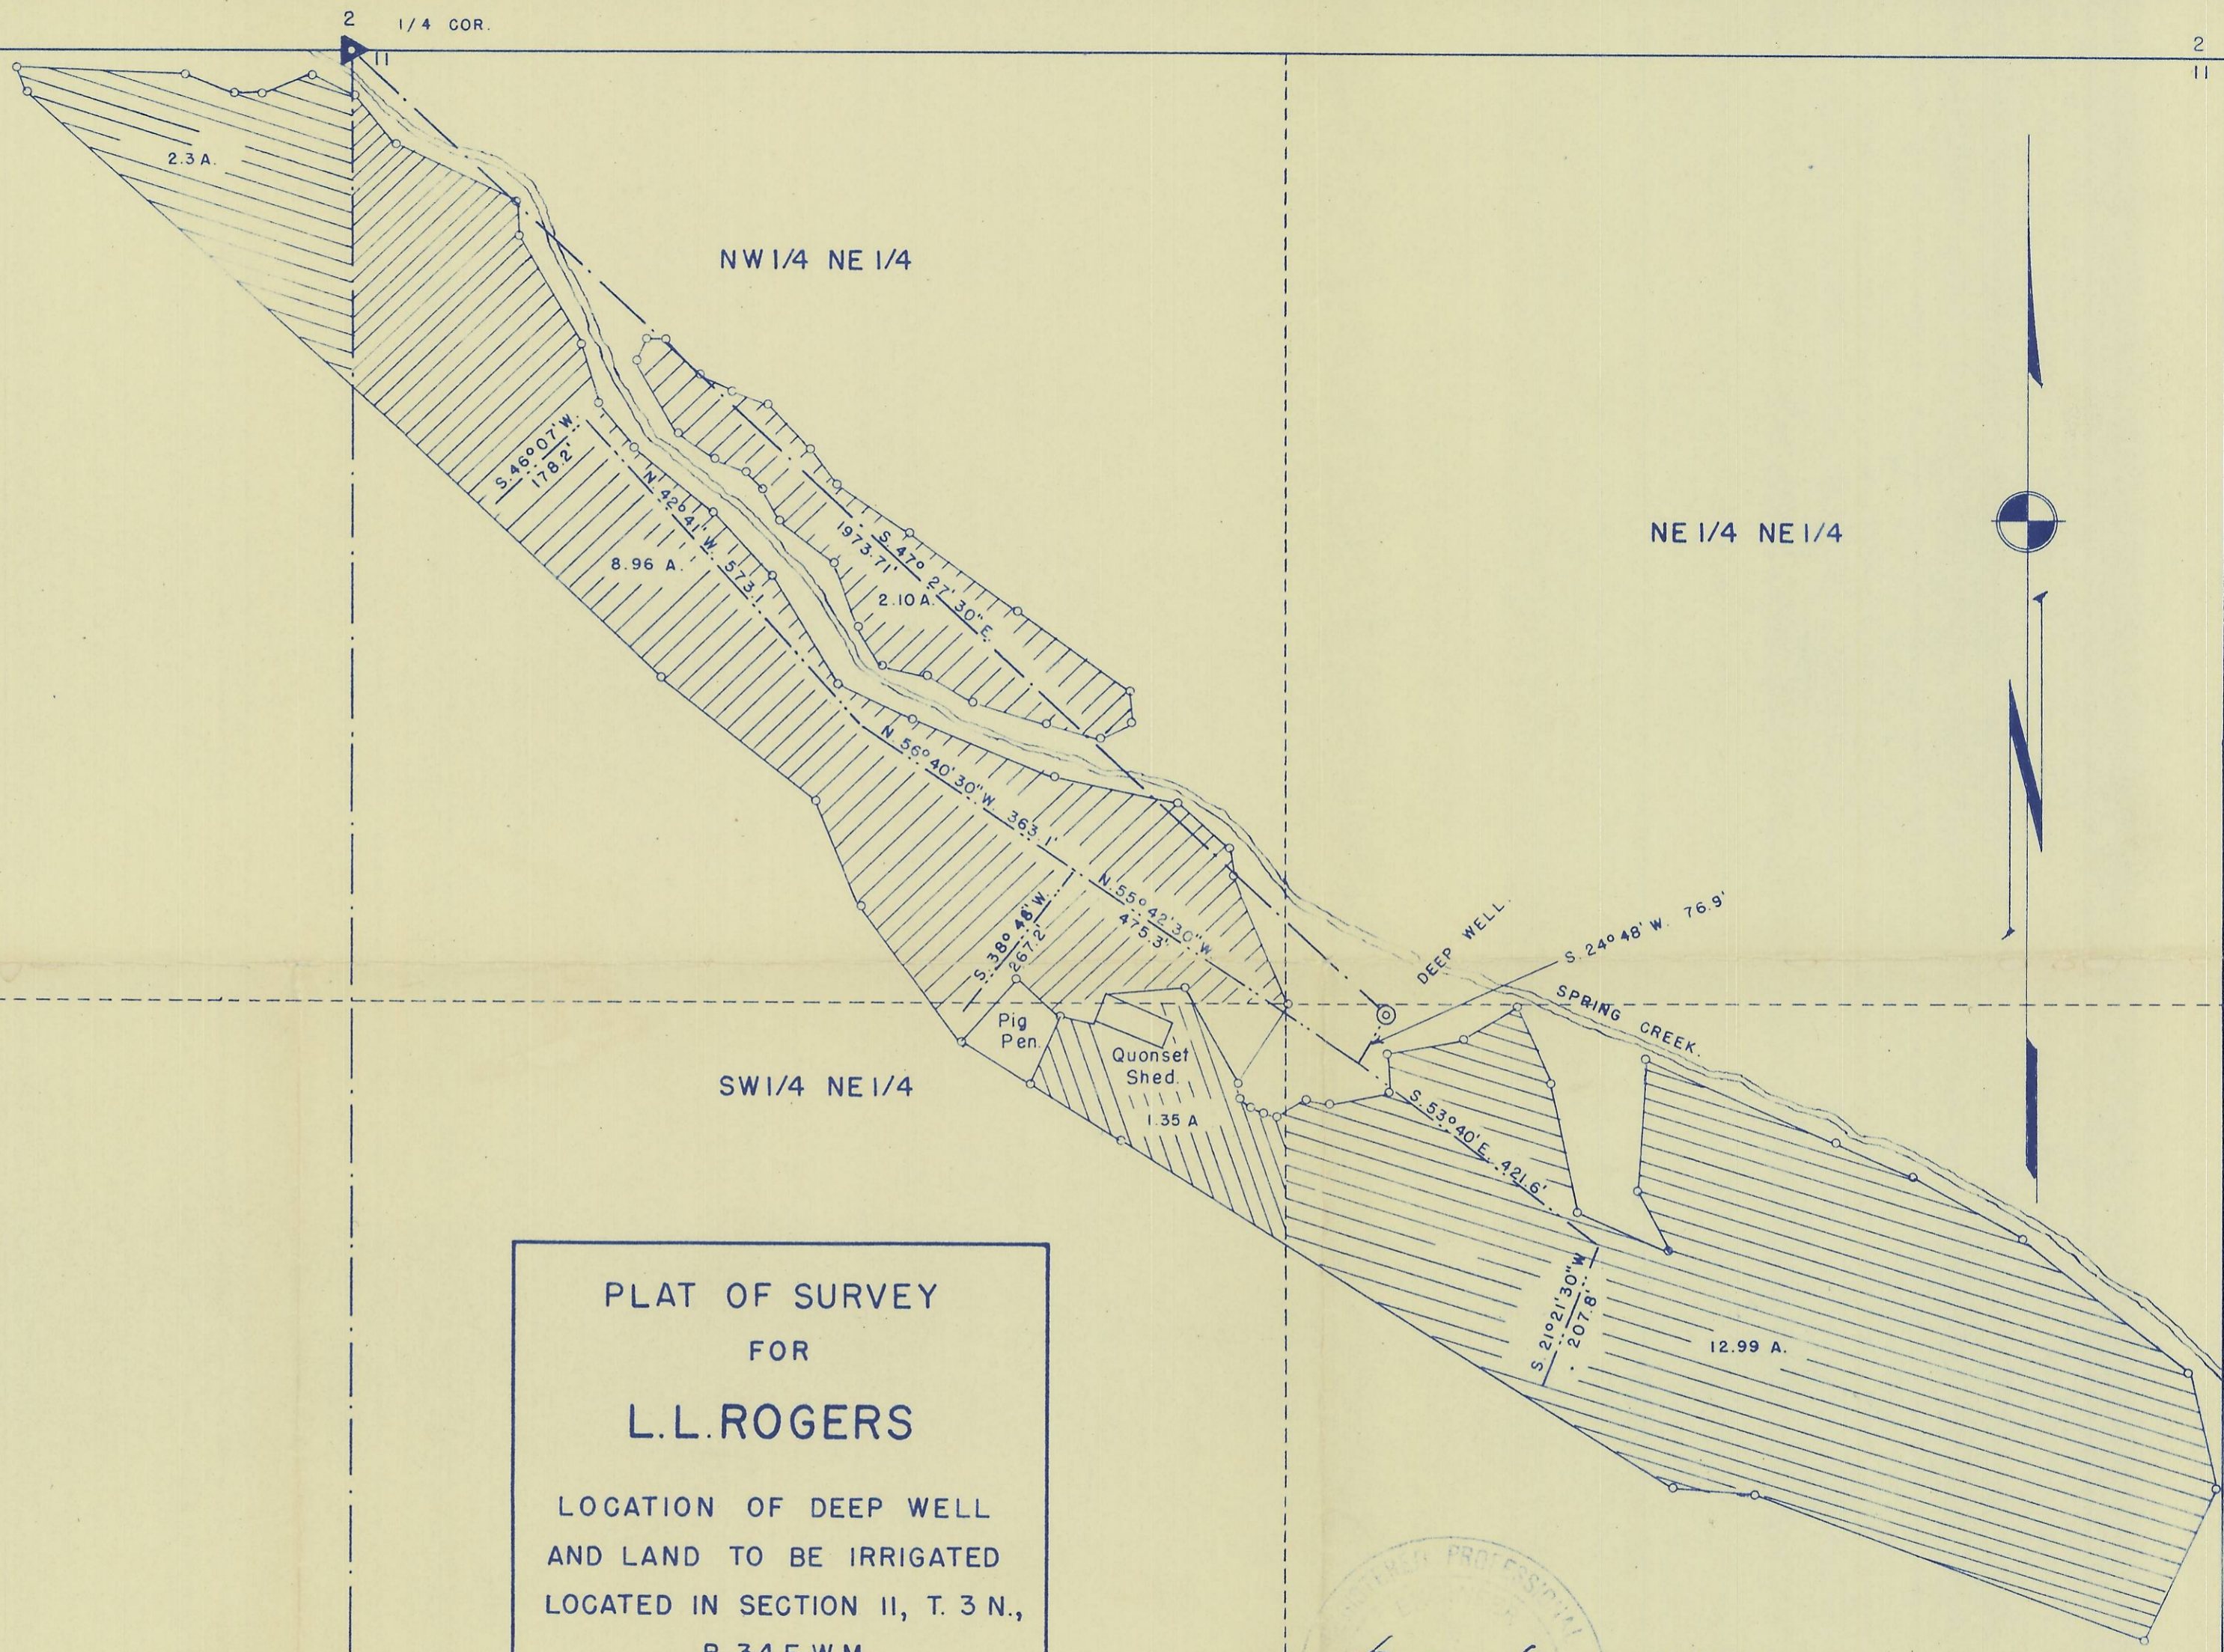

670 H-605-8