


T3N. R. 35E. W. 10
3
2
1

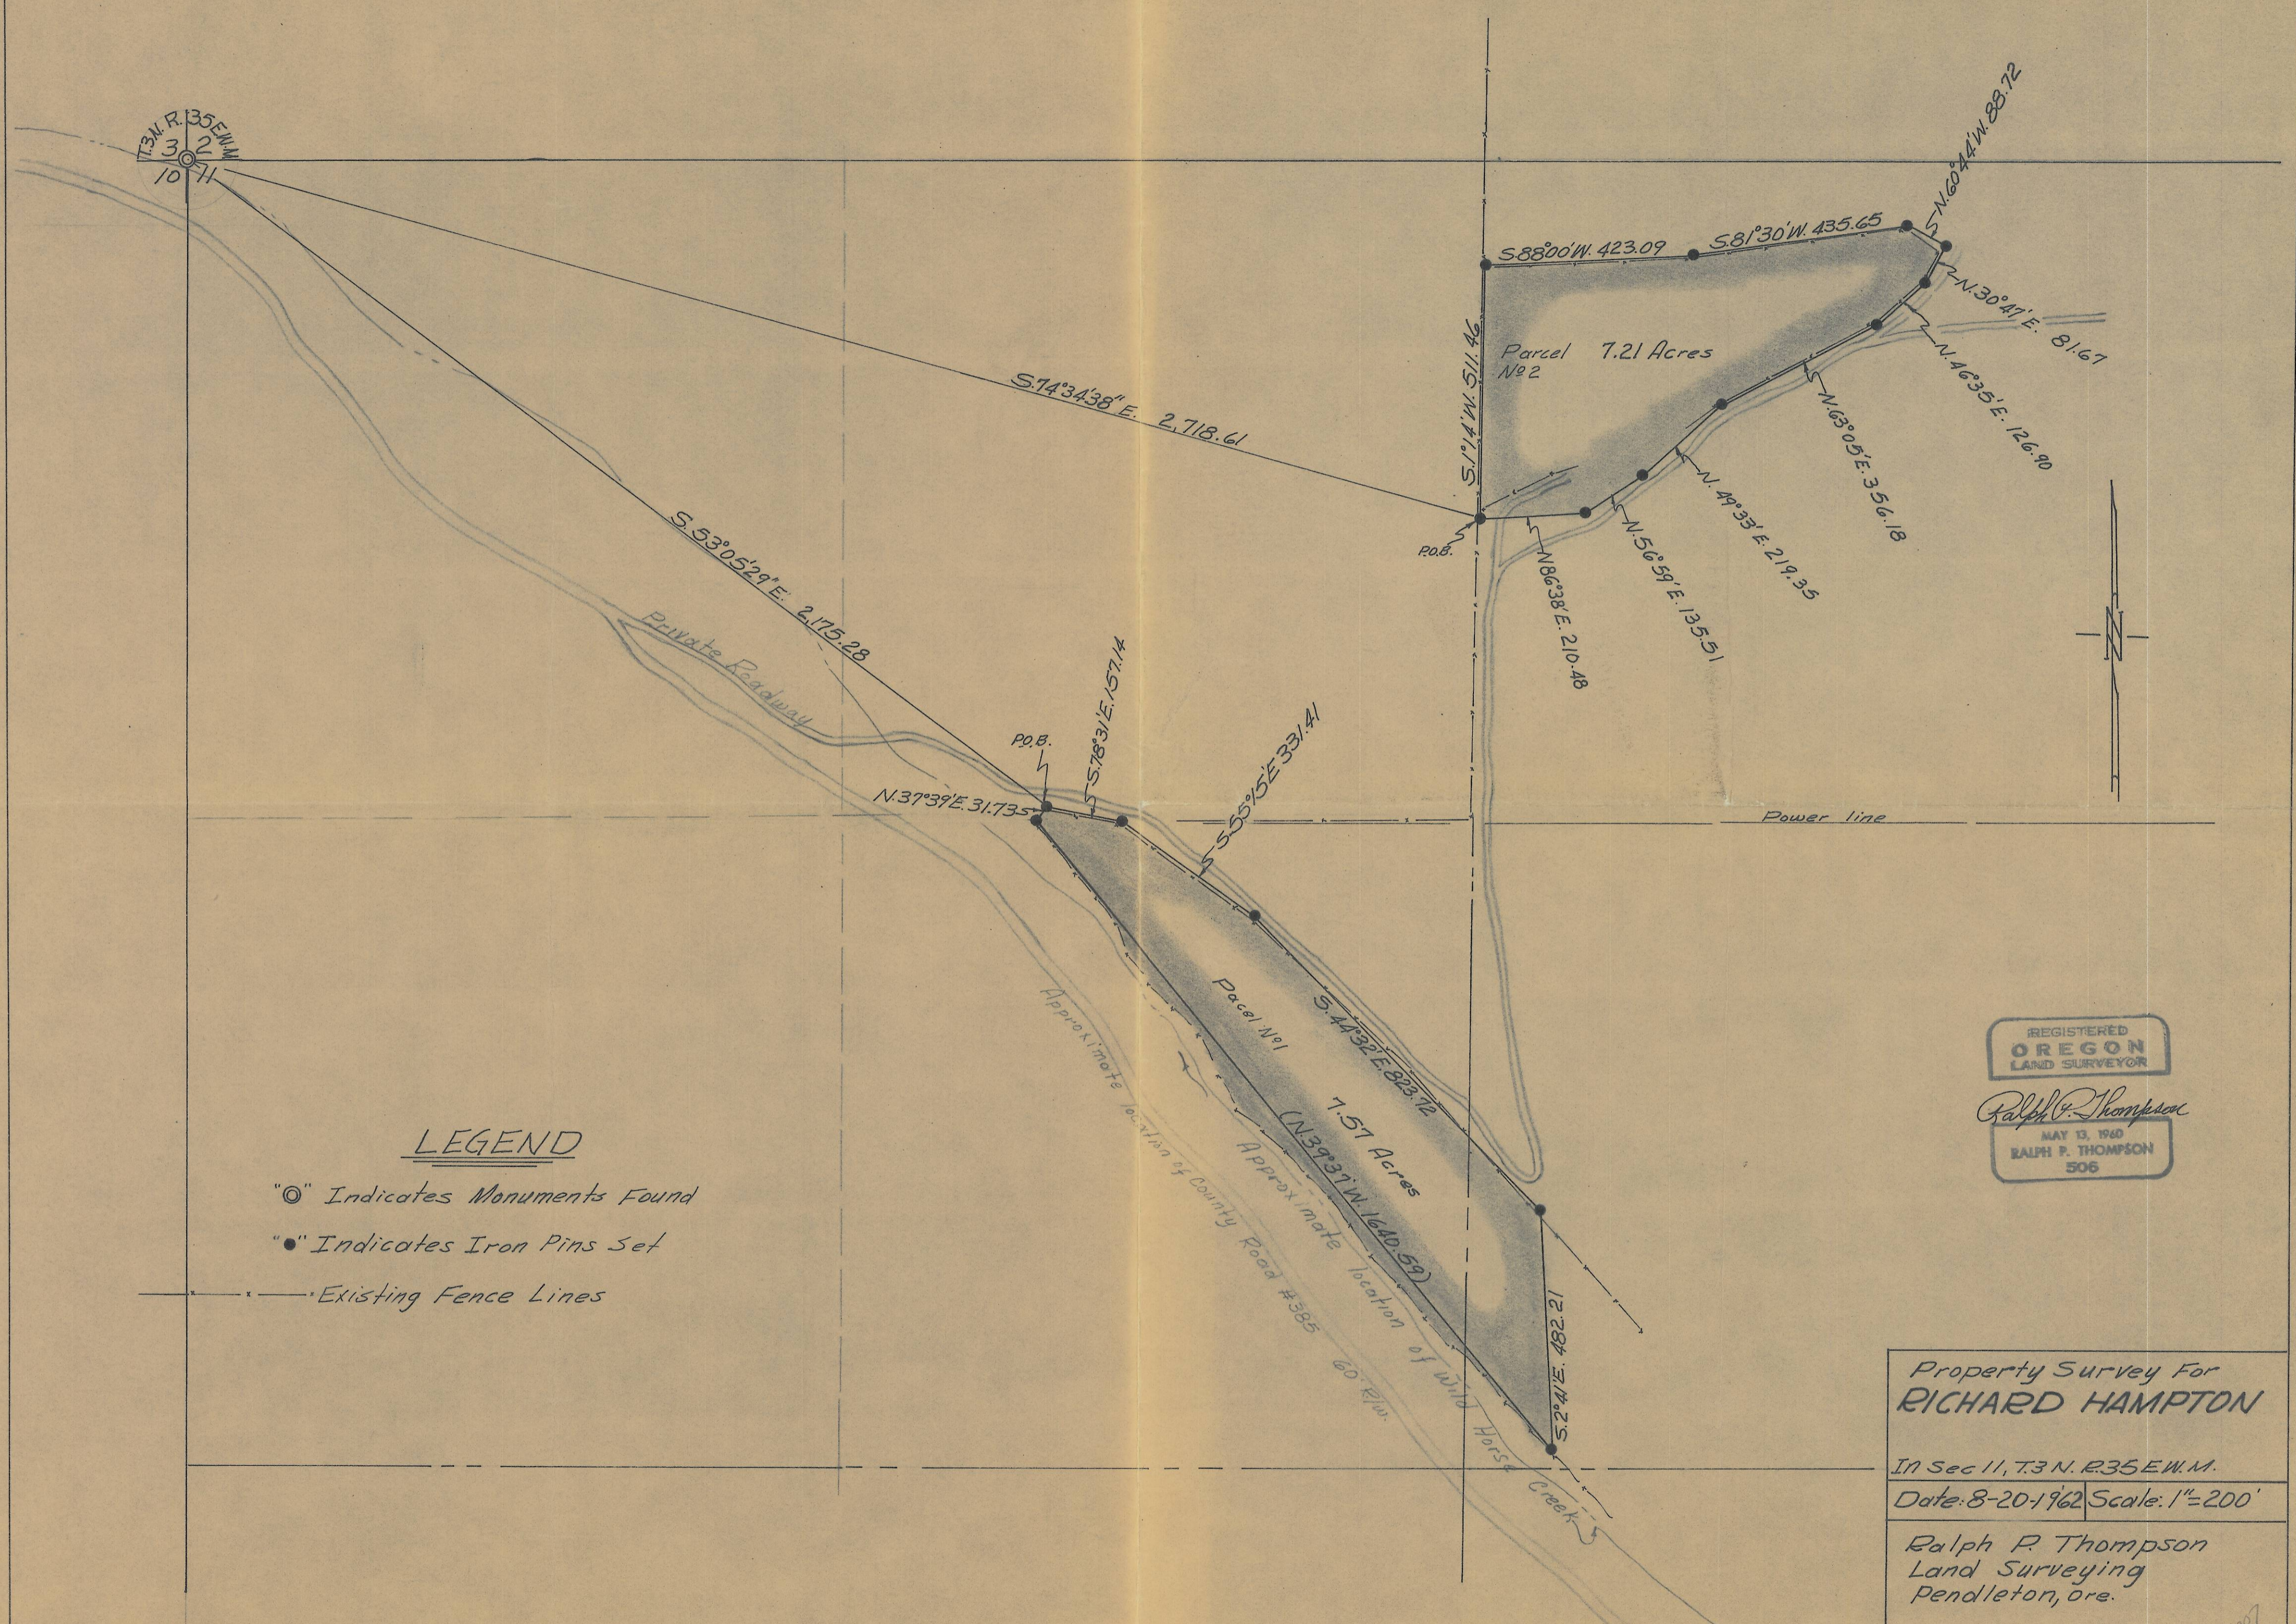

LEGEND

- "⊙" Indicates Monuments Found
- "•" Indicates Iron Pins Set
- Existing Fence Lines

REGISTERED
OREGON
LAND SURVEYOR
Ralph P. Thompson
MAY 13, 1960
RALPH P. THOMPSON
506

Property Survey For
RICHARD HAMPTON

IN Sec 11, T3 N. R35 E. W. 10
Date: 8-20-1962 Scale: 1"=200'

Ralph P. Thompson
Land Surveying
Pendleton, Ore.