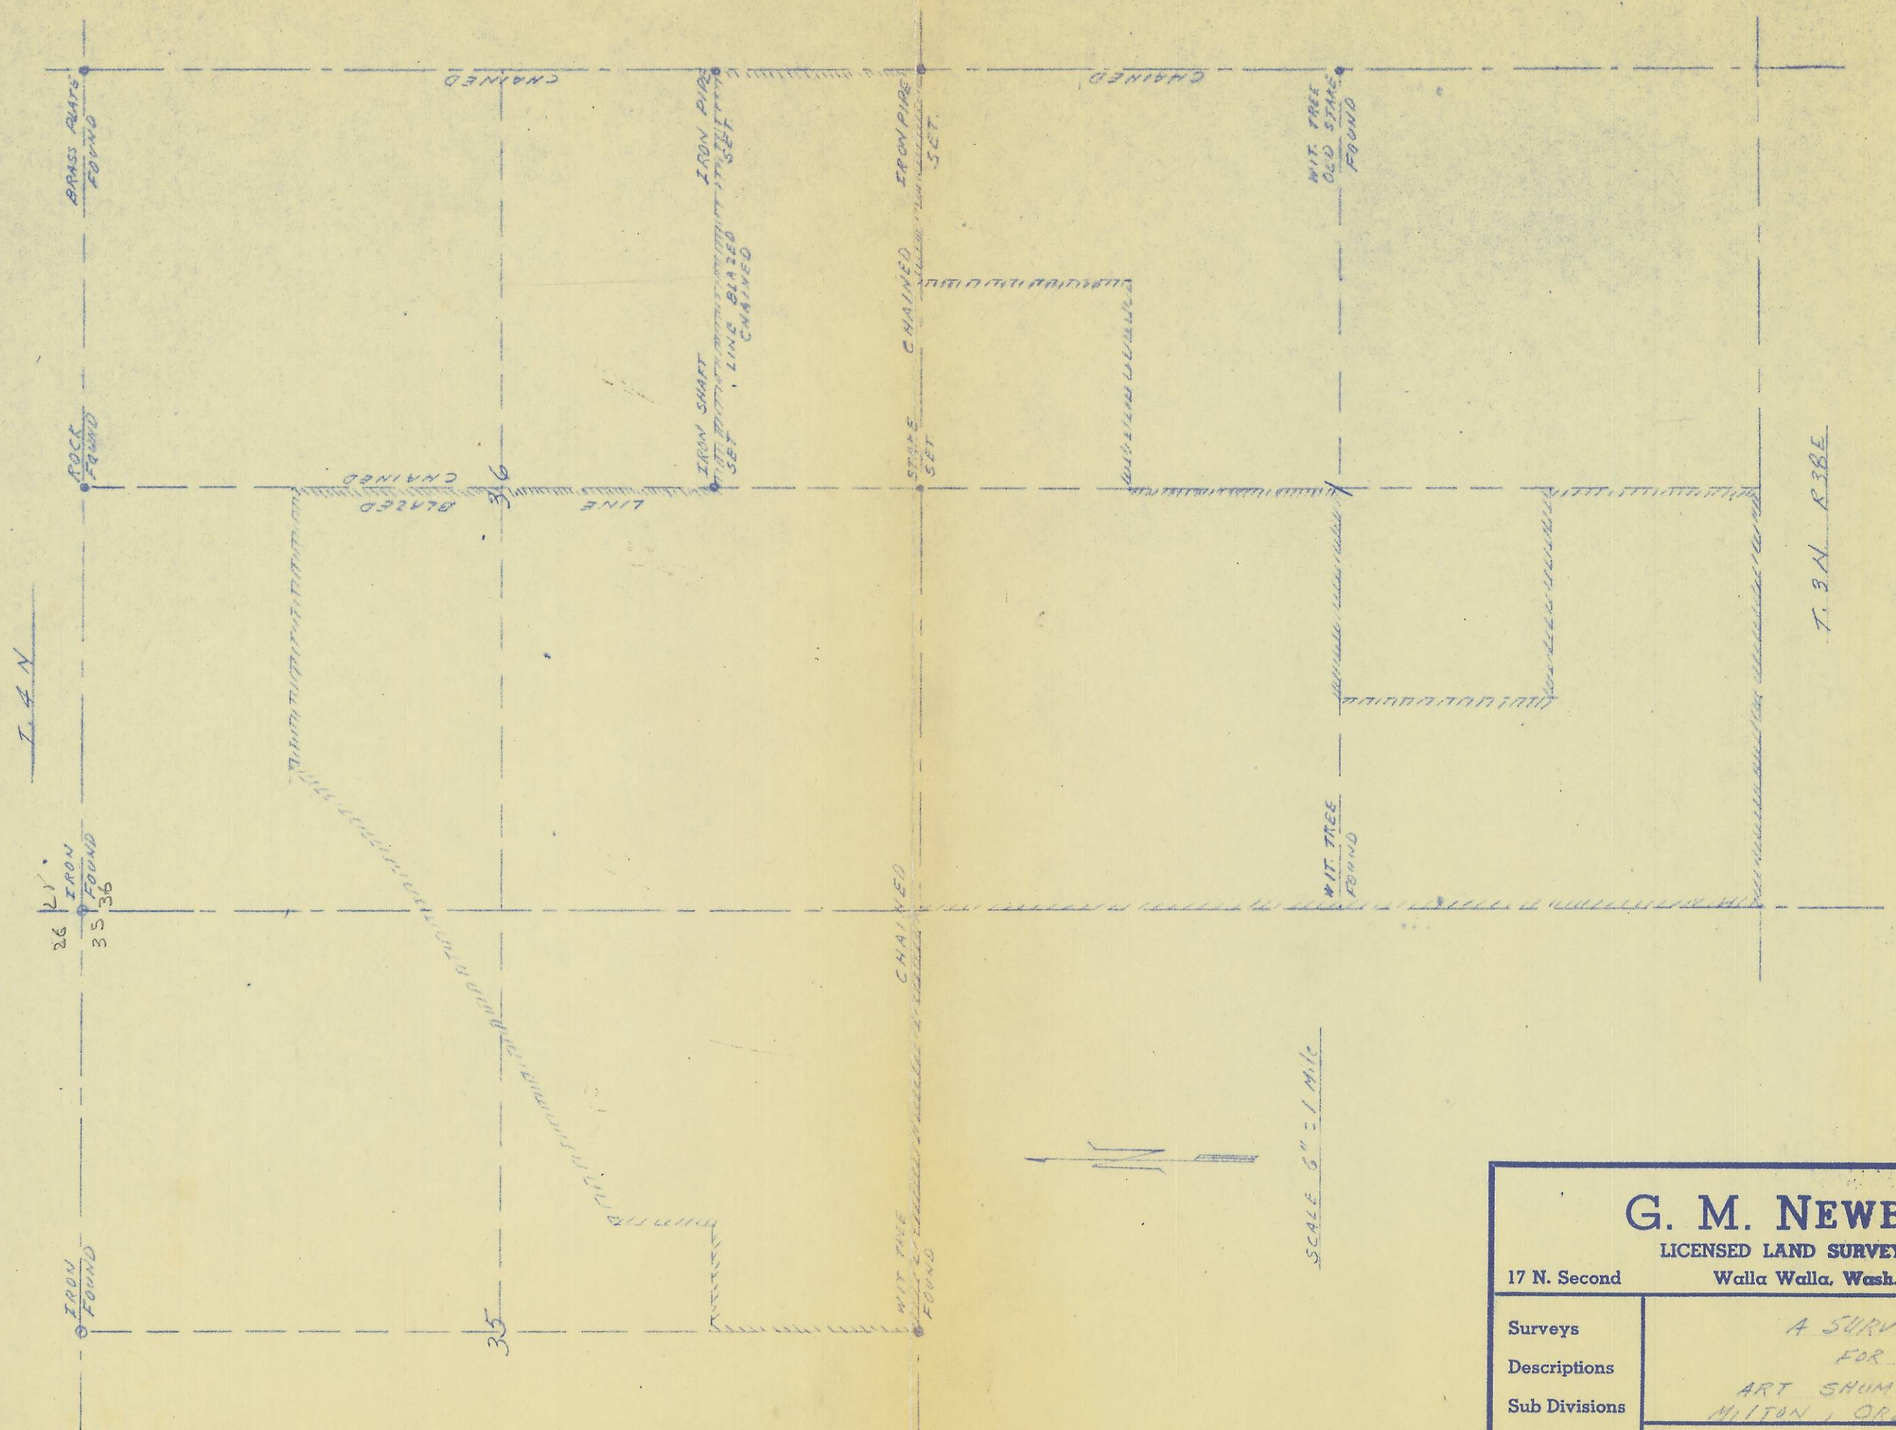

G. M. NEWBILL

LICENSED LAND SURVEYOR

17 N. Second — Walla Walla, Wash. — Phone 4170

Surveys Descriptions Sub Divisions	A SURVEY FOR ART SHUMWAY MILTON, OREGON
Date Drawn By Checked By	11/9/54 GMN
No.	1622

Q-757-A

4D 37 35 & 36 4 578