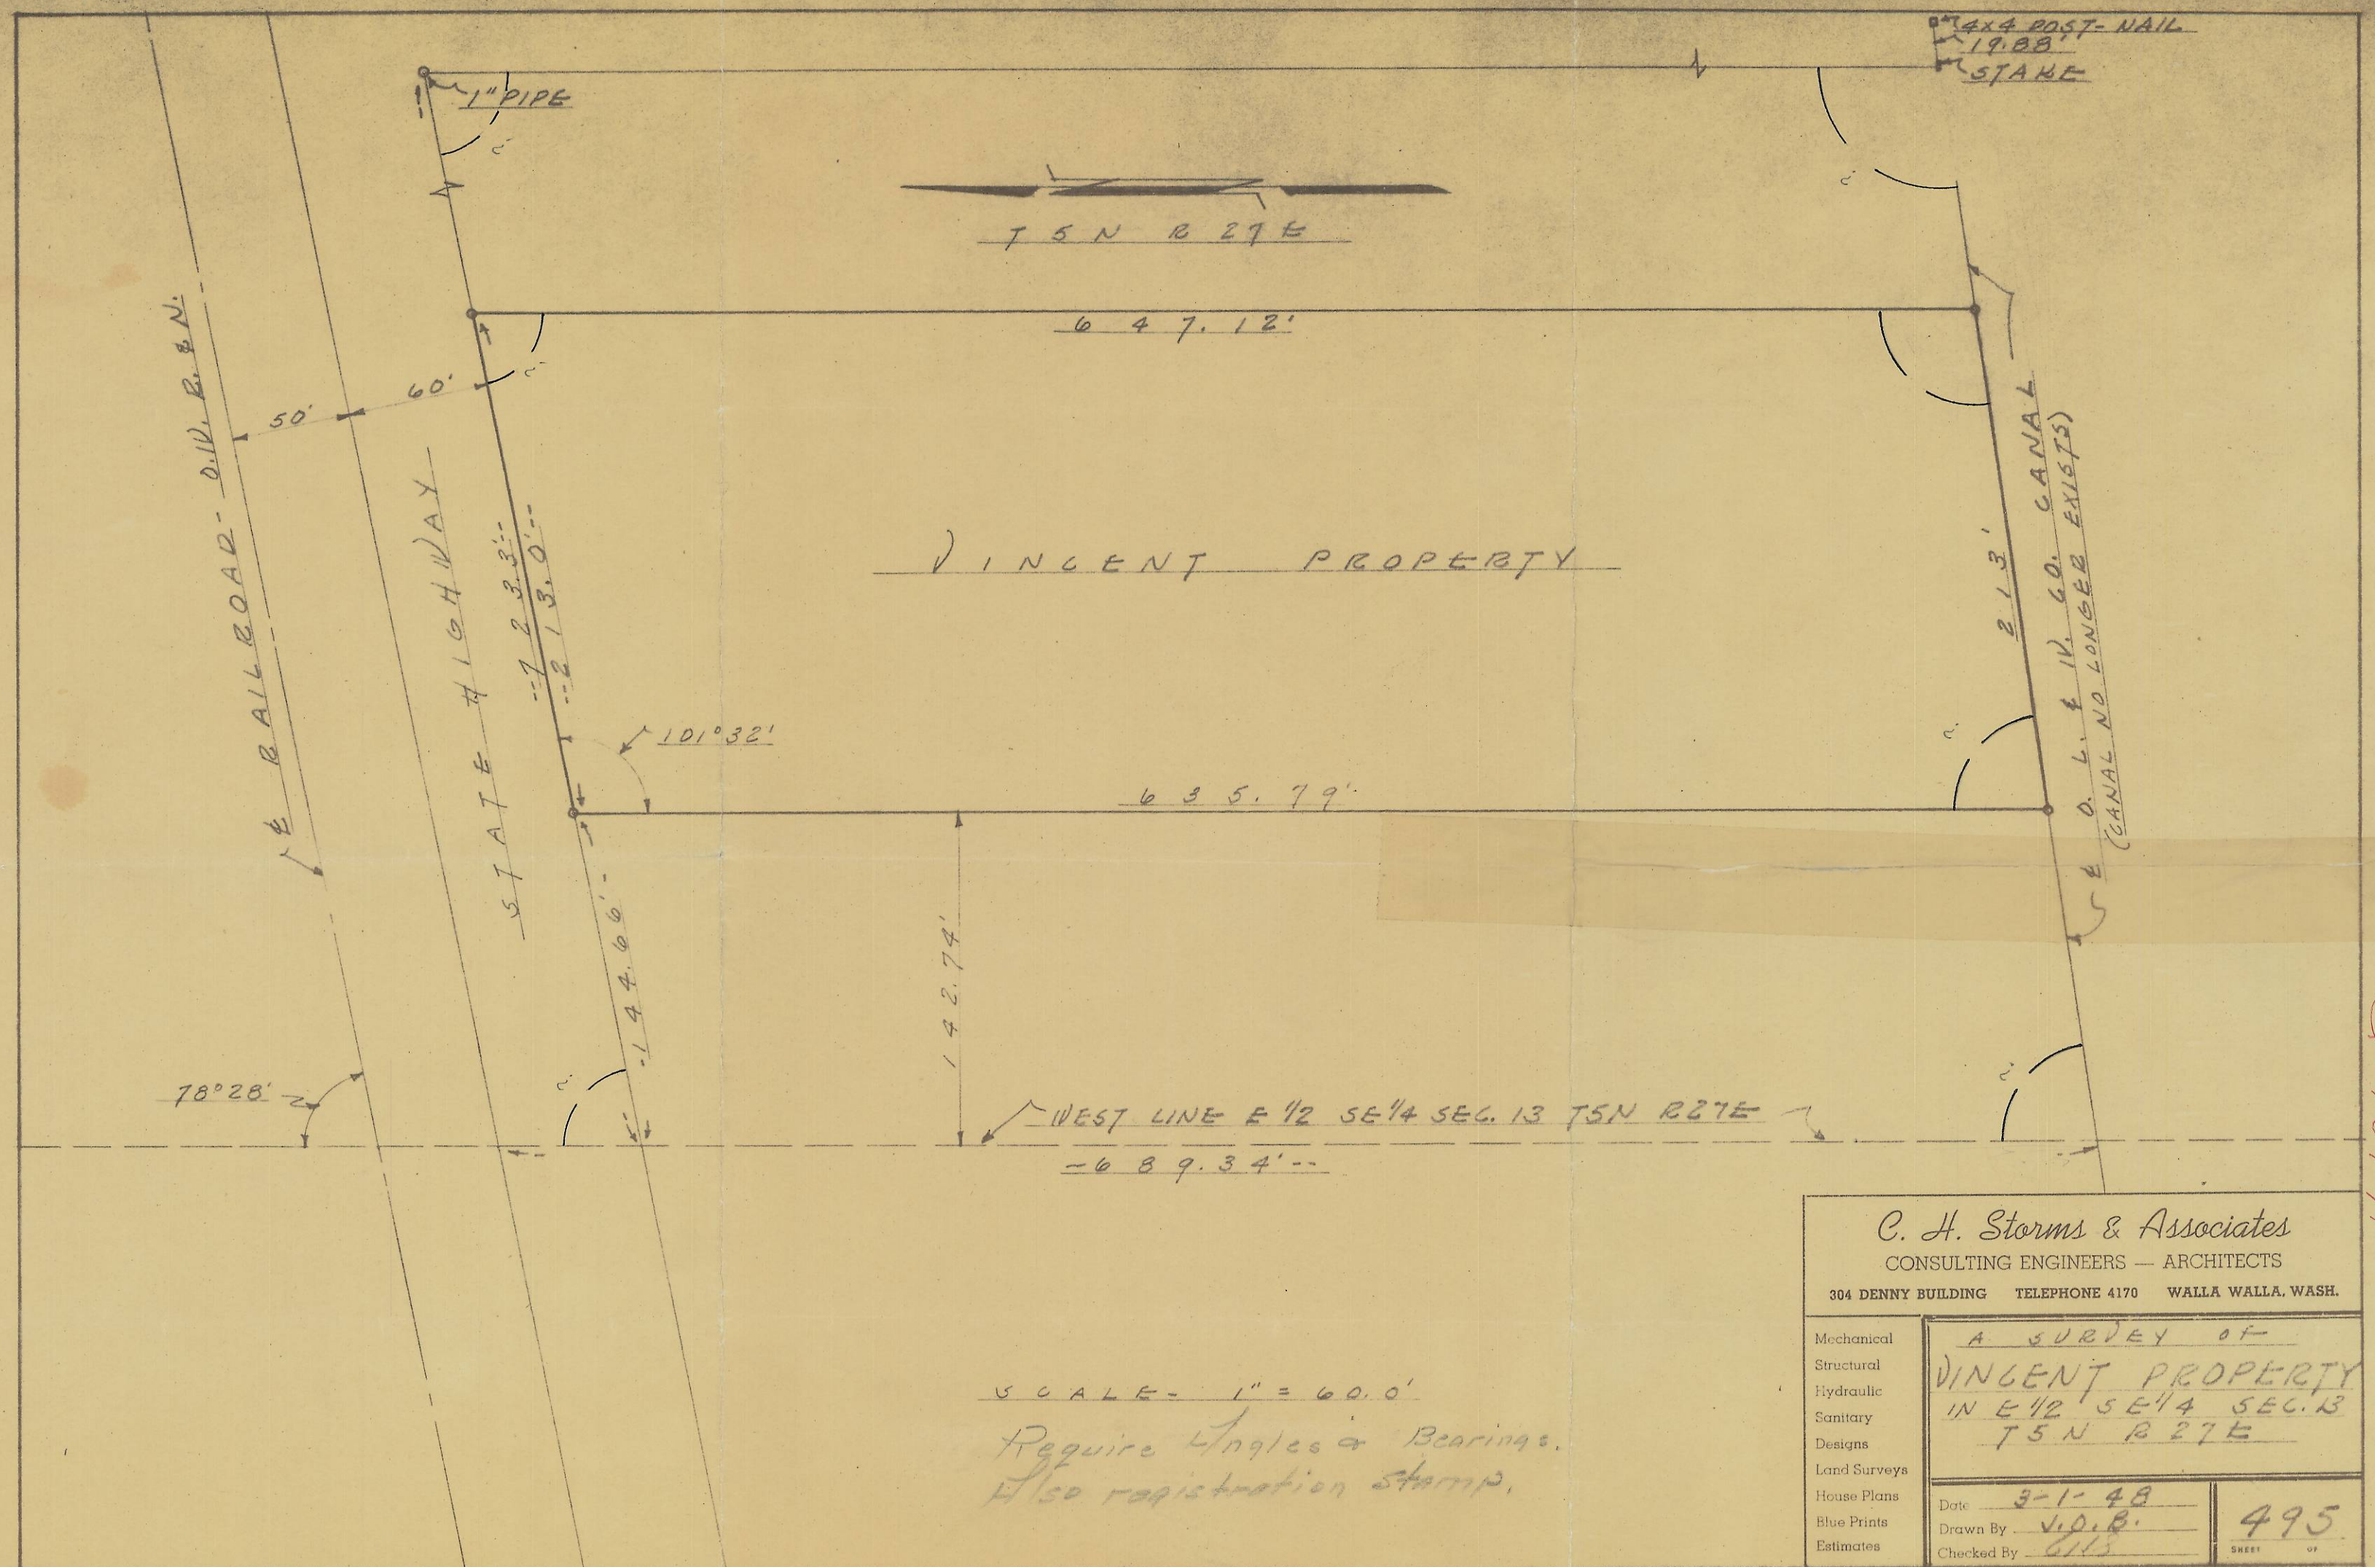
4x4 POST - NAIL
19.88'
STAKE
1" PIPE
T 5 N R 27 E
647.12'
50'
60'
℄ RAILROAD - O.W. R. & N.
STATE HIGHWAY
-723.3'-
-213.0'-
101°32'
VINCENT PROPERTY
635.79'
213'
℄ O. L. & W. CO. CANAL
(CANAL NO LONGER EXISTS)
142.74'
-144.66'-
78°28'
WEST LINE E 1/2 SE 1/4 SEC. 13 T5N R27E
-689.34'-
SCALE- 1" = 60.0'
Require Angles & Bearings.
Also registration stamp.
C. H. Storms & Associates
CONSULTING ENGINEERS — ARCHITECTS
304 DENNY BUILDING TELEPHONE 4170 WALLA WALLA, WASH.
Mechanical
Structural
Hydraulic
Sanitary
Designs
Land Surveys
House Plans
Blue Prints
Estimates
A SURVEY OF
VINCENT PROPERTY
IN E 1/2 SE 1/4 SEC. 13
T5N R27E
Date 3-1-48
Drawn By V.D.B.
Checked By CHS
495
SHEET OF
610