


Q-873-A

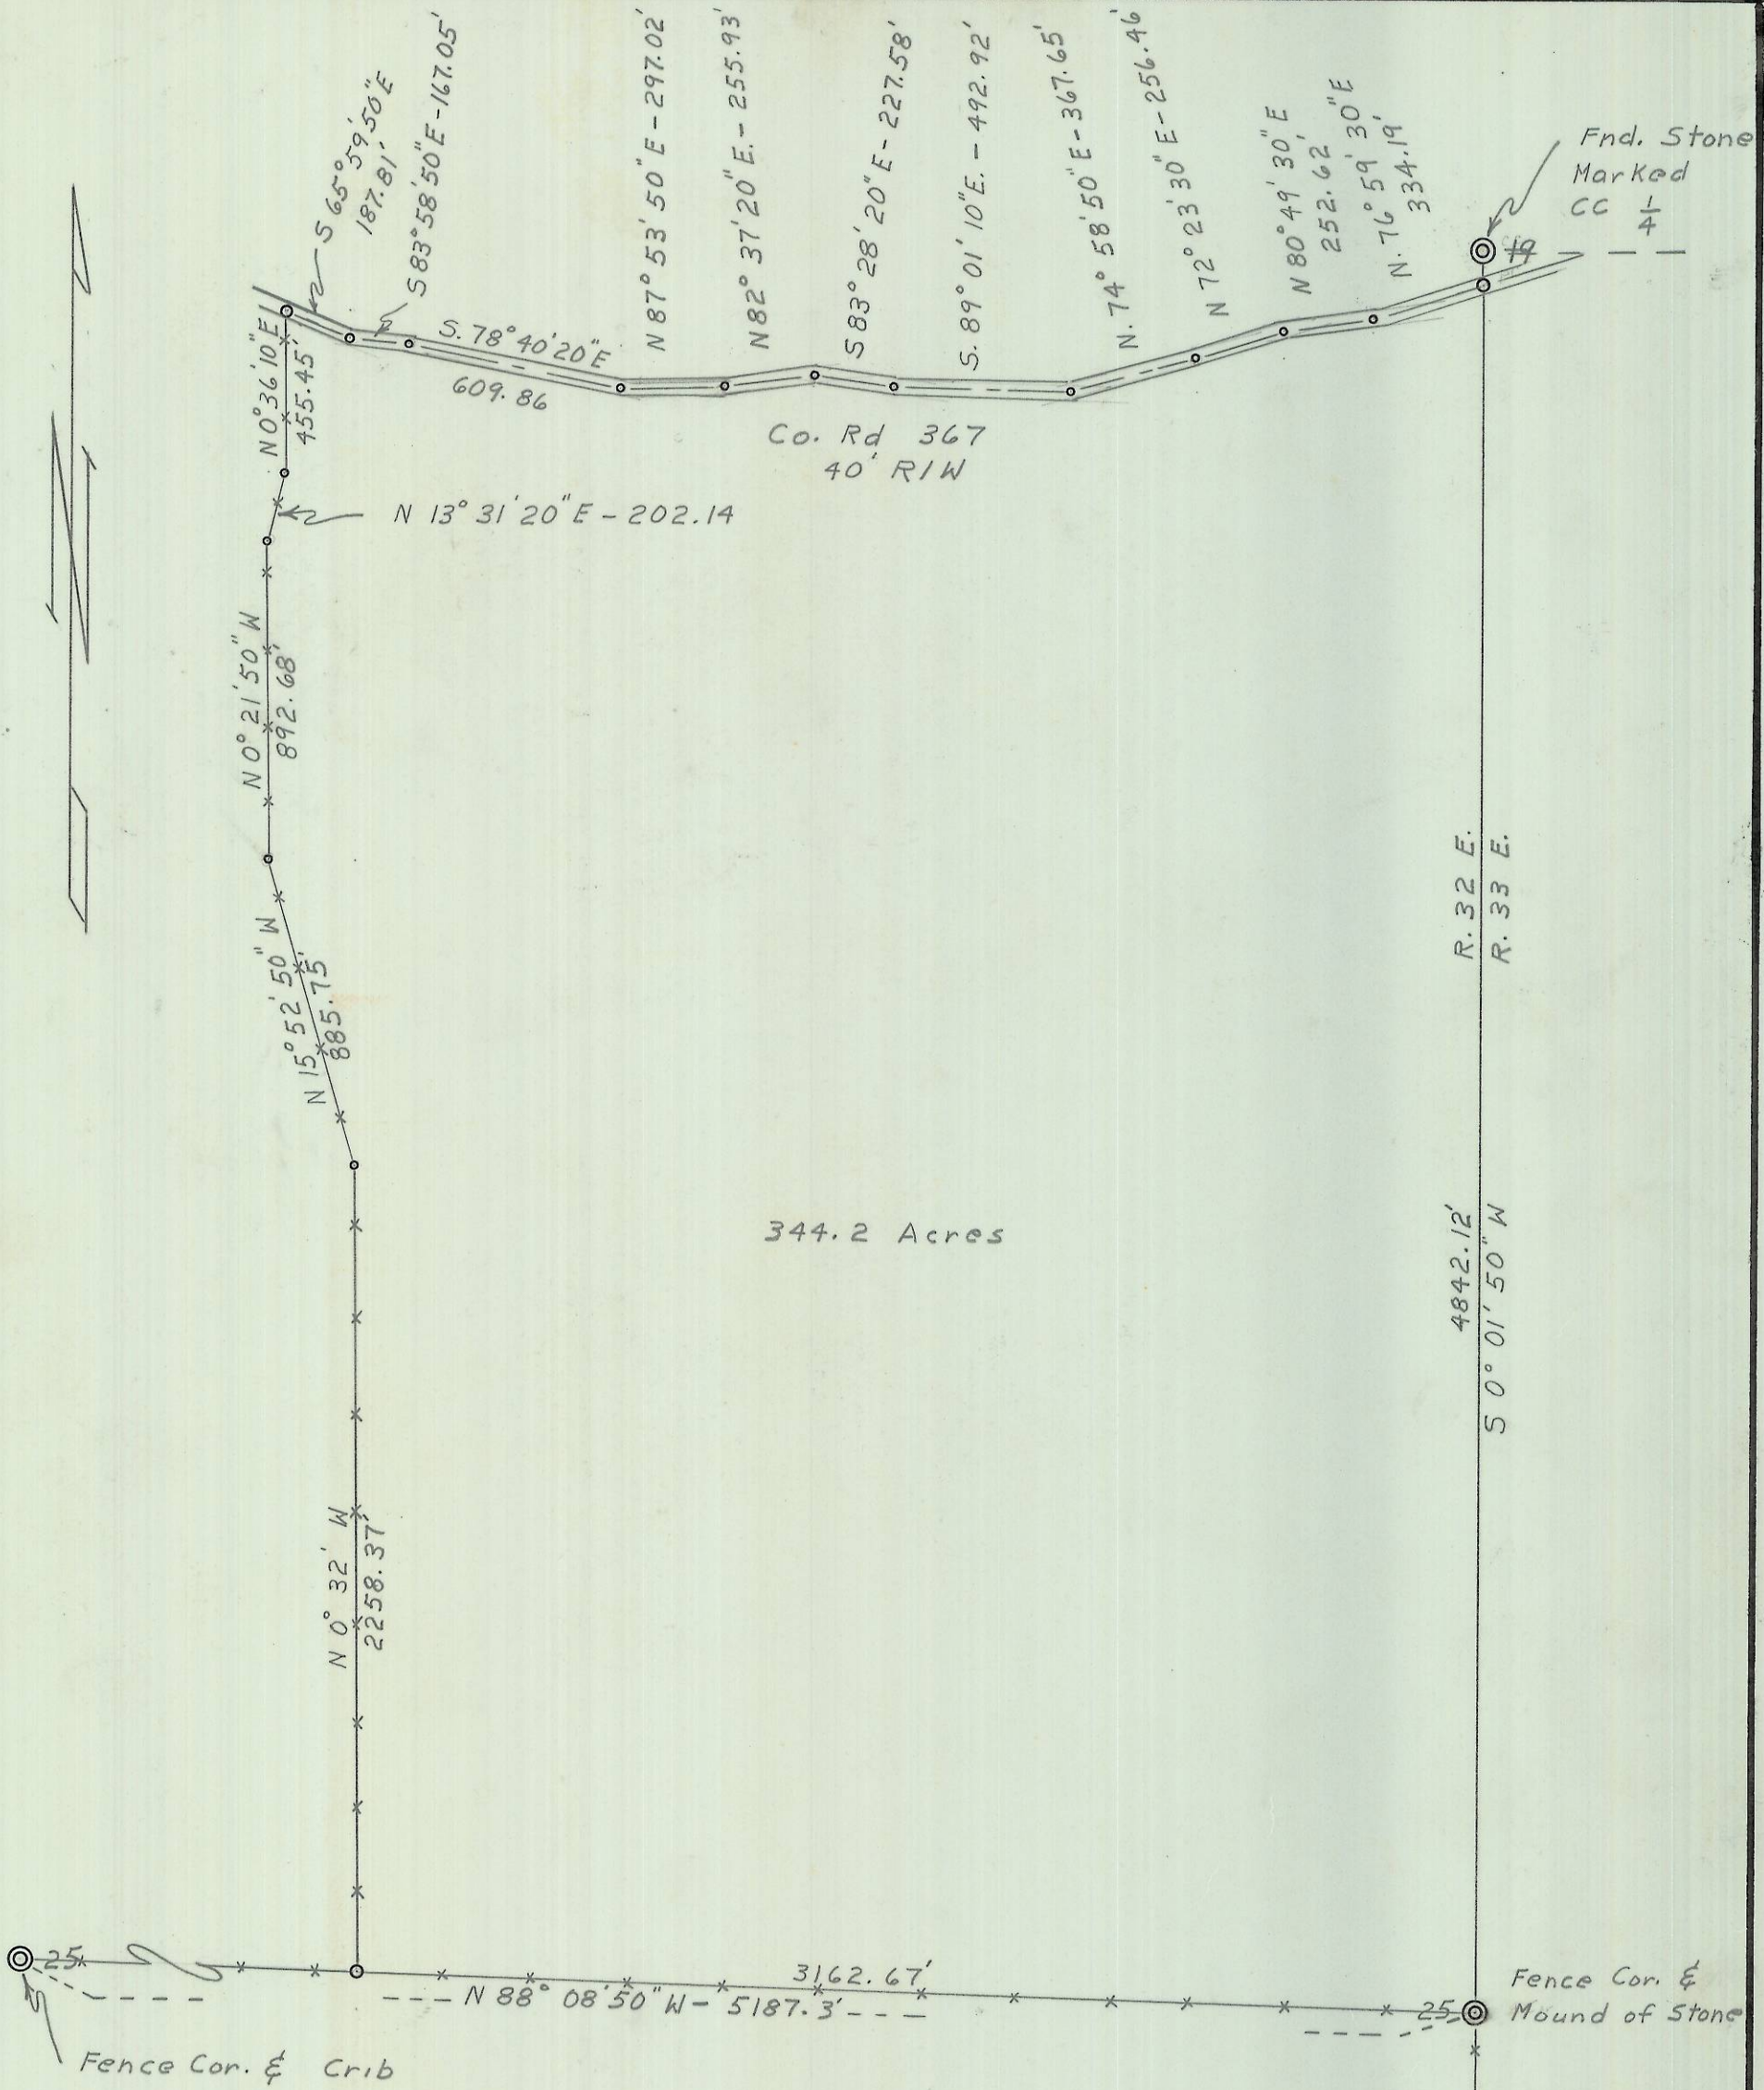

Q-873-A

REGISTERED
OREGON
 LAND SURVEYOR

Wayne O. Harris
 MAY 6, 1955
WAYNE O. HARRIS
 346

HAYES AND HARRIS			
SURVEY FOR			
WILBERT HORN			
PARCEL IN SECTIONS 24 & 25			
T. 1 S., R. 32 E., W.M.			
SCALE	DATE	DRN. BY	DRNG. NO.
1" = 500'	11/28/61	WOH	61-117 A