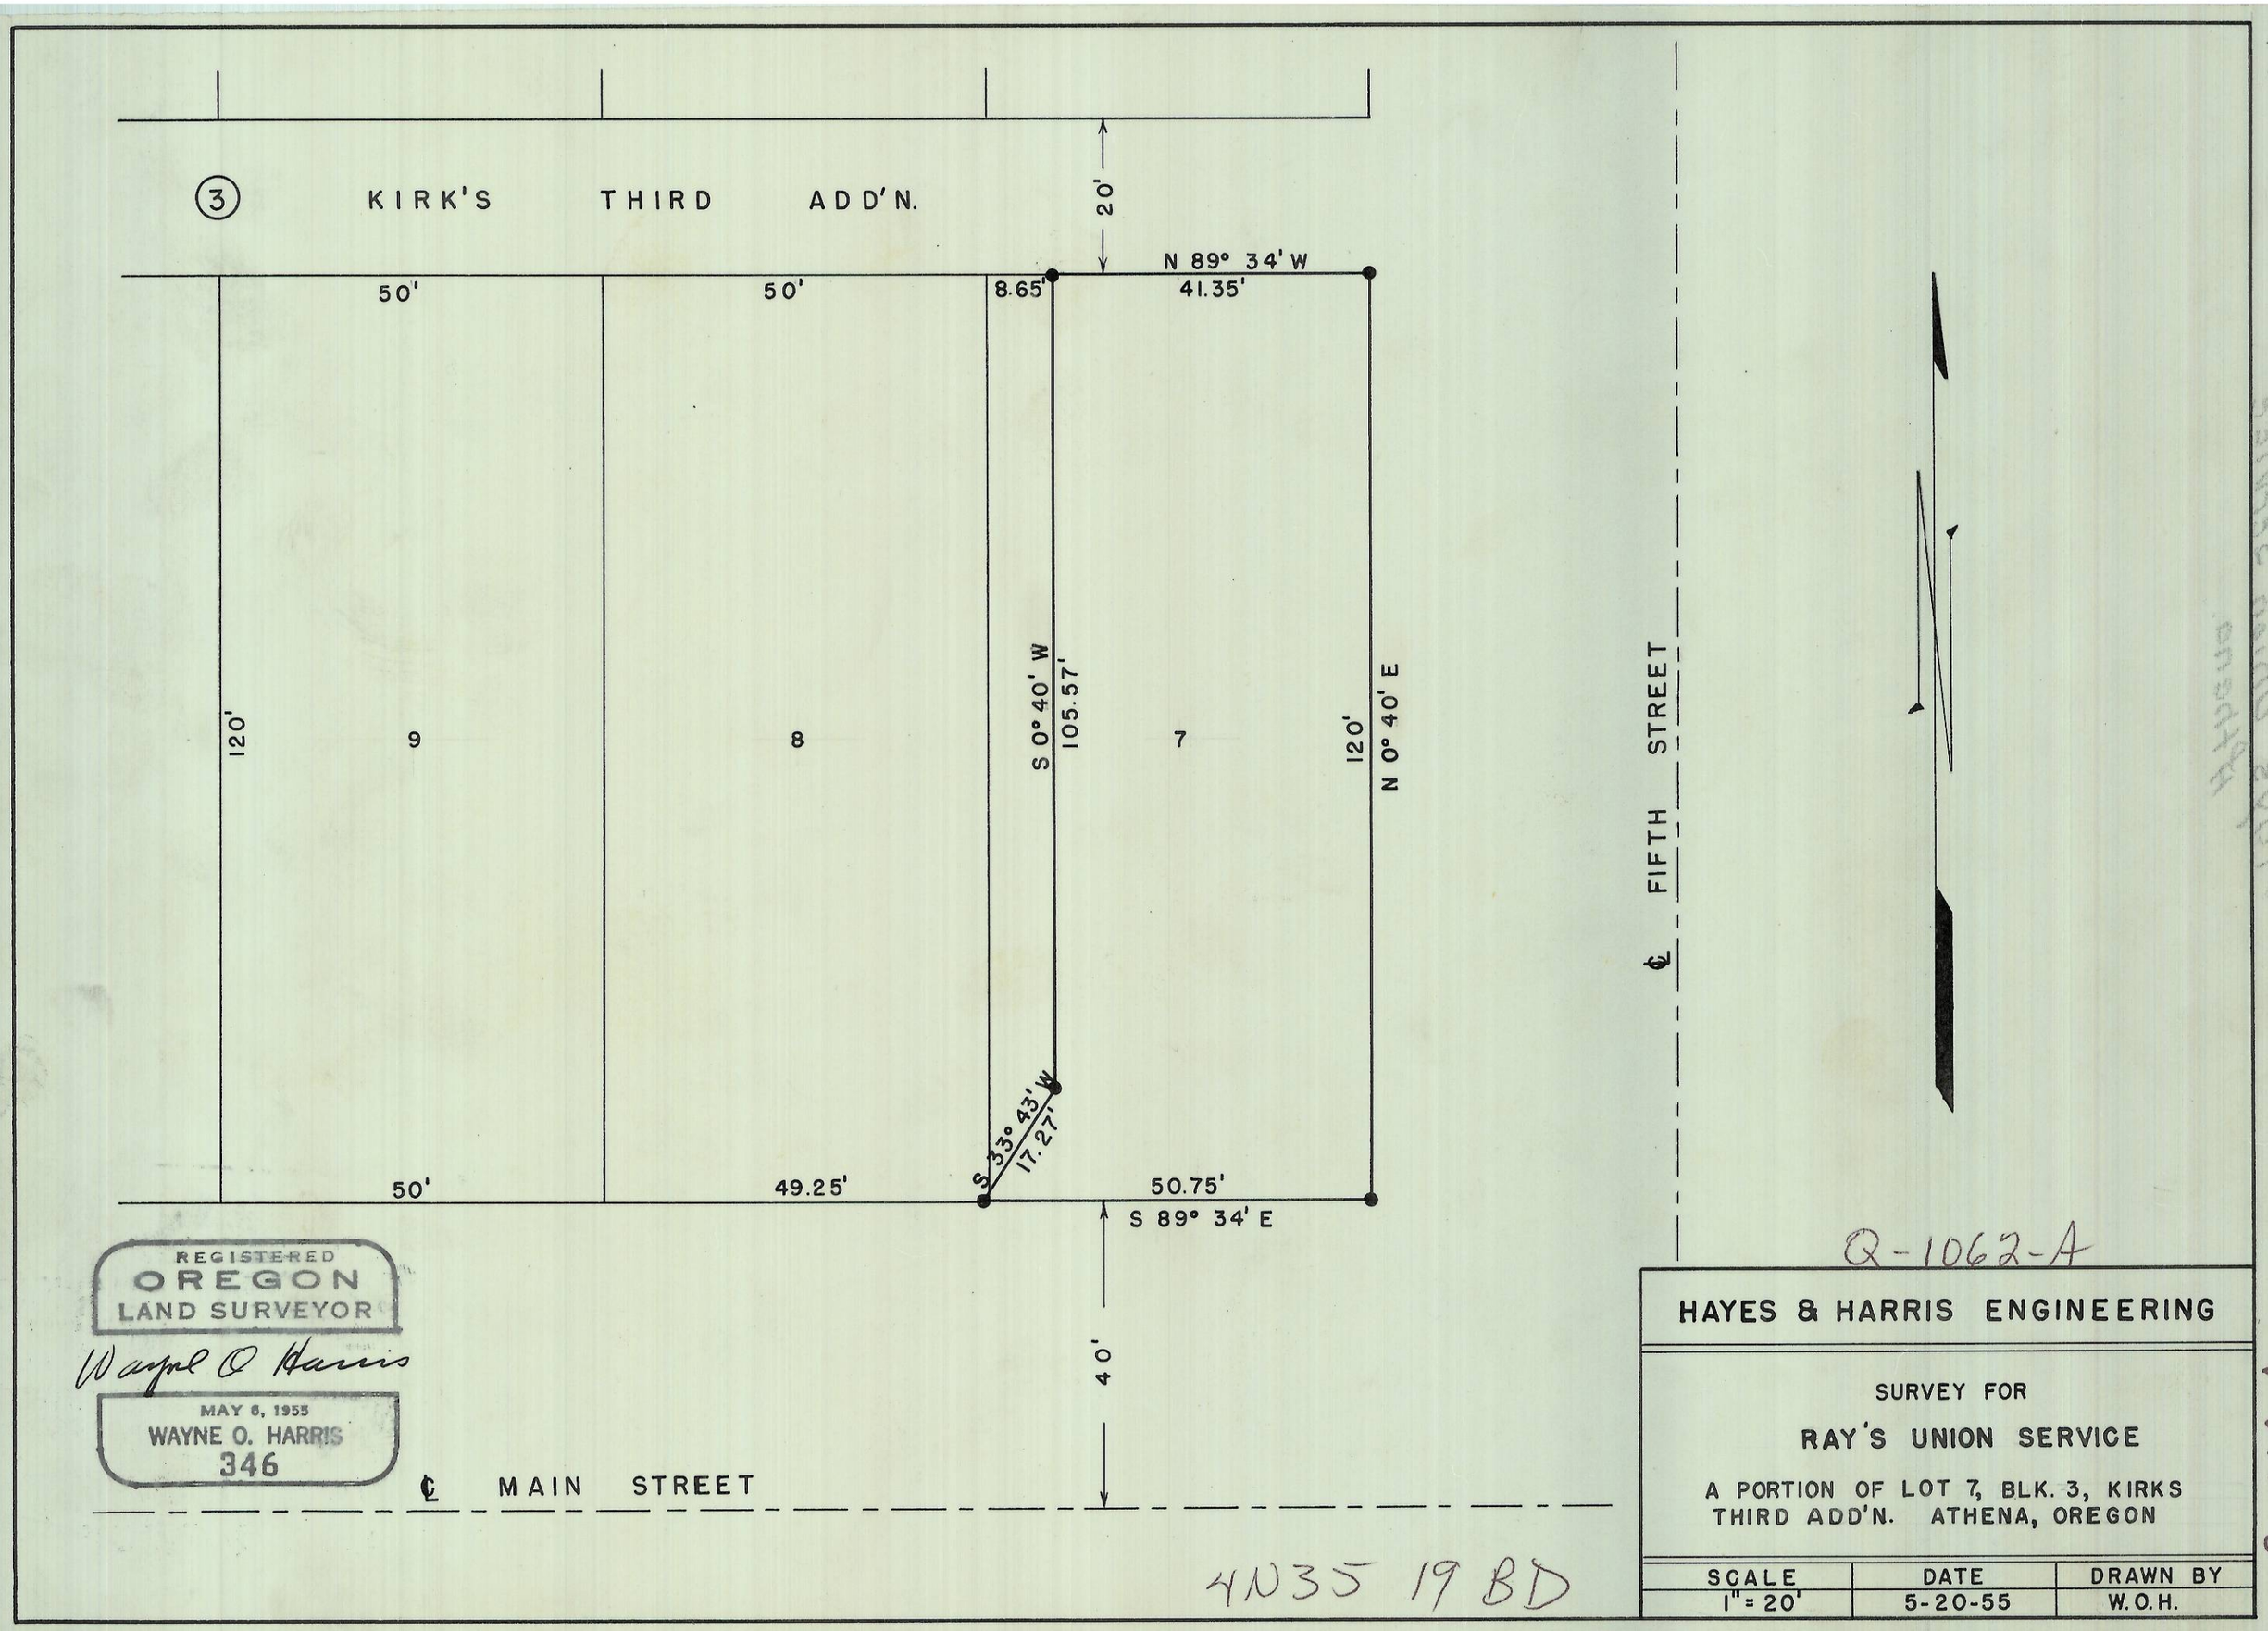

3
KIRK'S THIRD ADD'N.
20'
N 89° 34' W
41.35'
50'
50'
8.65'
120'
9
8
S 0° 40' W
105.57'
7
120'
N 0° 40' E
S 33° 43' W
17.27'
50'
49.25'
50.75'
S 89° 34' E
40'
℄ MAIN STREET
℄ FIFTH STREET
REGISTERED
OREGON
LAND SURVEYOR
Wayne O Harris
MAY 6, 1955
WAYNE O. HARRIS
346
Q-1062-A
HAYES & HARRIS ENGINEERING
SURVEY FOR
RAY'S UNION SERVICE
A PORTION OF LOT 7, BLK. 3, KIRKS
THIRD ADD'N. ATHENA, OREGON
SCALE
1" = 20'
DATE
5-20-55
DRAWN BY
W.O.H.
4N35 19 BD
Q-1062-A
10-A
10A