


TRACT IN SEC. 14-4N-28E.

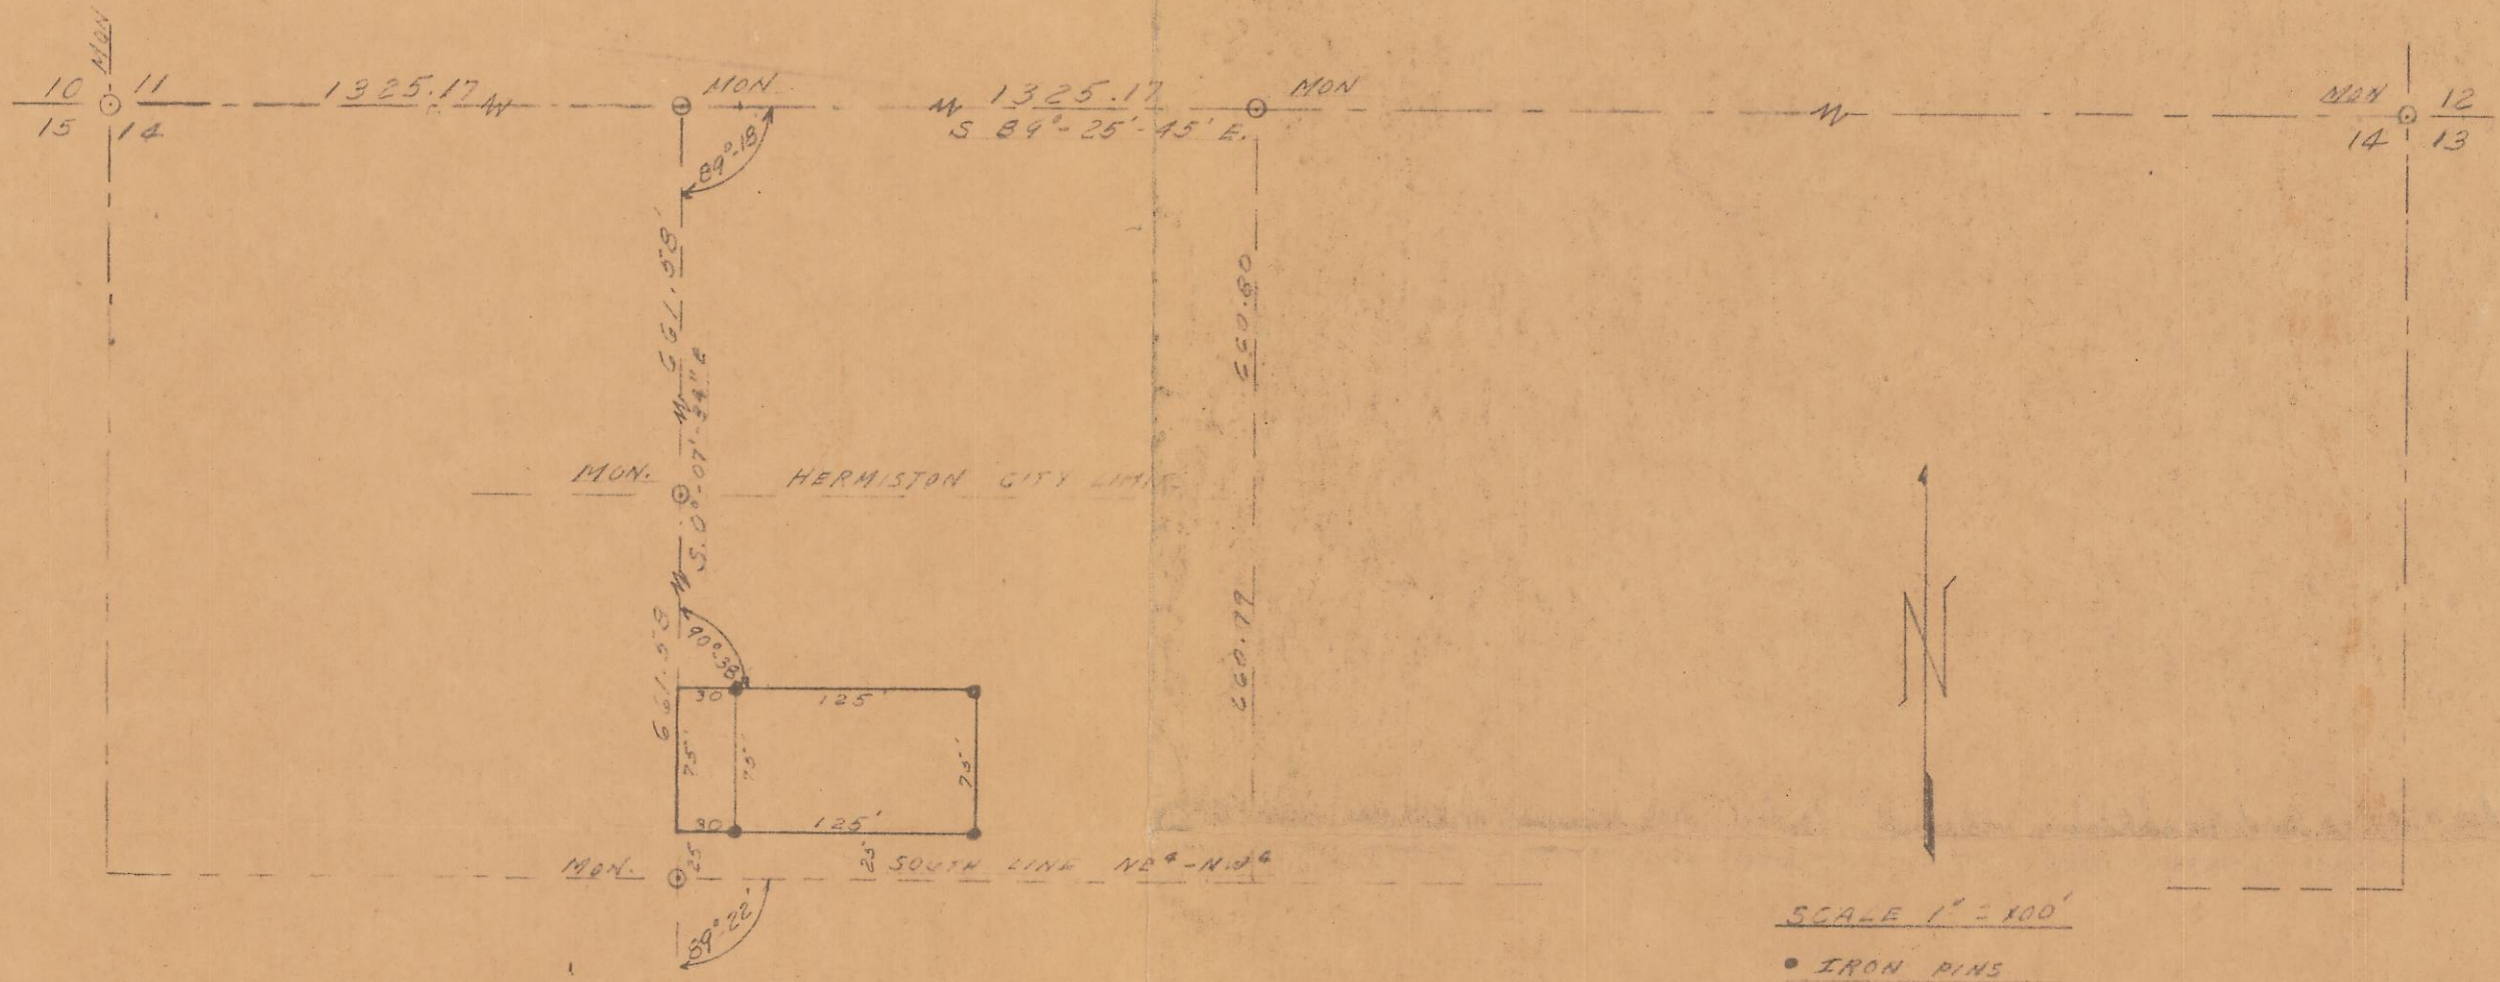

637

REGISTERED  
OREGON  
LAND SURVEYOR

B. H. Maxwell

G. M. NEWBILL

Q-1324-A

A SURVEY  
IN  
NE<sup>4</sup>-NW<sup>4</sup> SEC 14-4N-28E  
FOR  
SAM SELLERS 637

Date	4/16/52	# 1308
Drawn By	G.M.H.	
Checked By	✓	SHEET 1 OF 1