




Scale: 1" = 100'

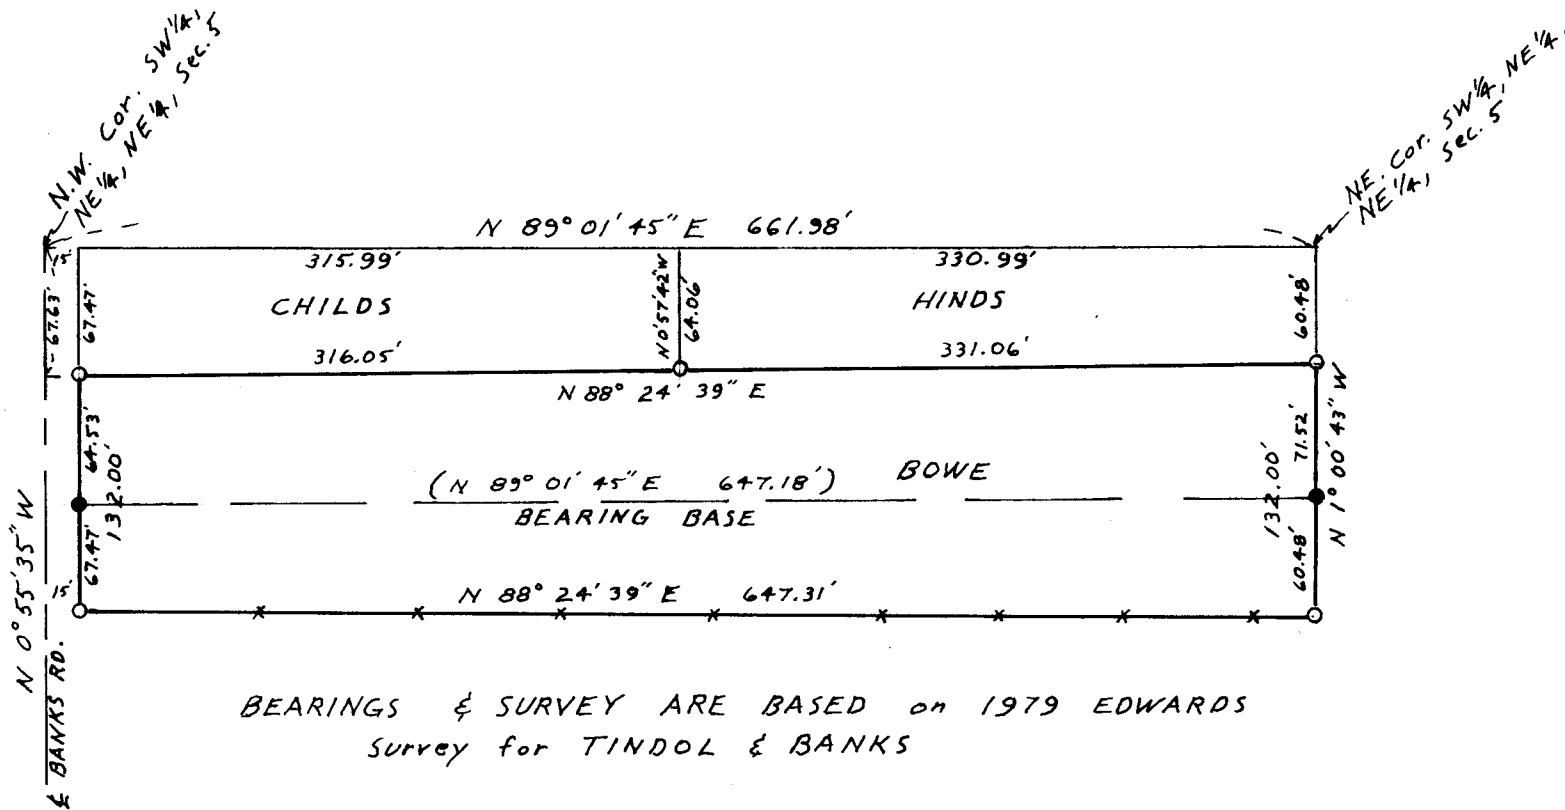

BEARINGS & SURVEY ARE BASED ON 1979 EDWARDS Survey for TINDOL & BANKS

REGISTERED
PROFESSIONAL
LAND SURVEYOR

G. Dennis Edwards

OREGON
JULY 16, 1971
G. DENNIS EDWARDS
951

B2-014-AY

SURVEY FOR BOWE, CHILDS, & HINDS

In NE 1/4 Sec. 5, T4N, R29E, W.M. Umatilla Co., Ore.

11/9/81

• 1/2" Iron Rods Fnd.

Job # 5811122

o 1/2" Iron Rods Set

(000) of record

EDWARDS SURVEYING P.O. Box 763 HERMISTON, ORE.

567-3336