

RECEIVED BY

Umatilla County Surveyor


Date 11-82

Rec'd by BLS

No. 82-128-Ax



QUINNEY COURT
(TOWNHOUSE PLAT)

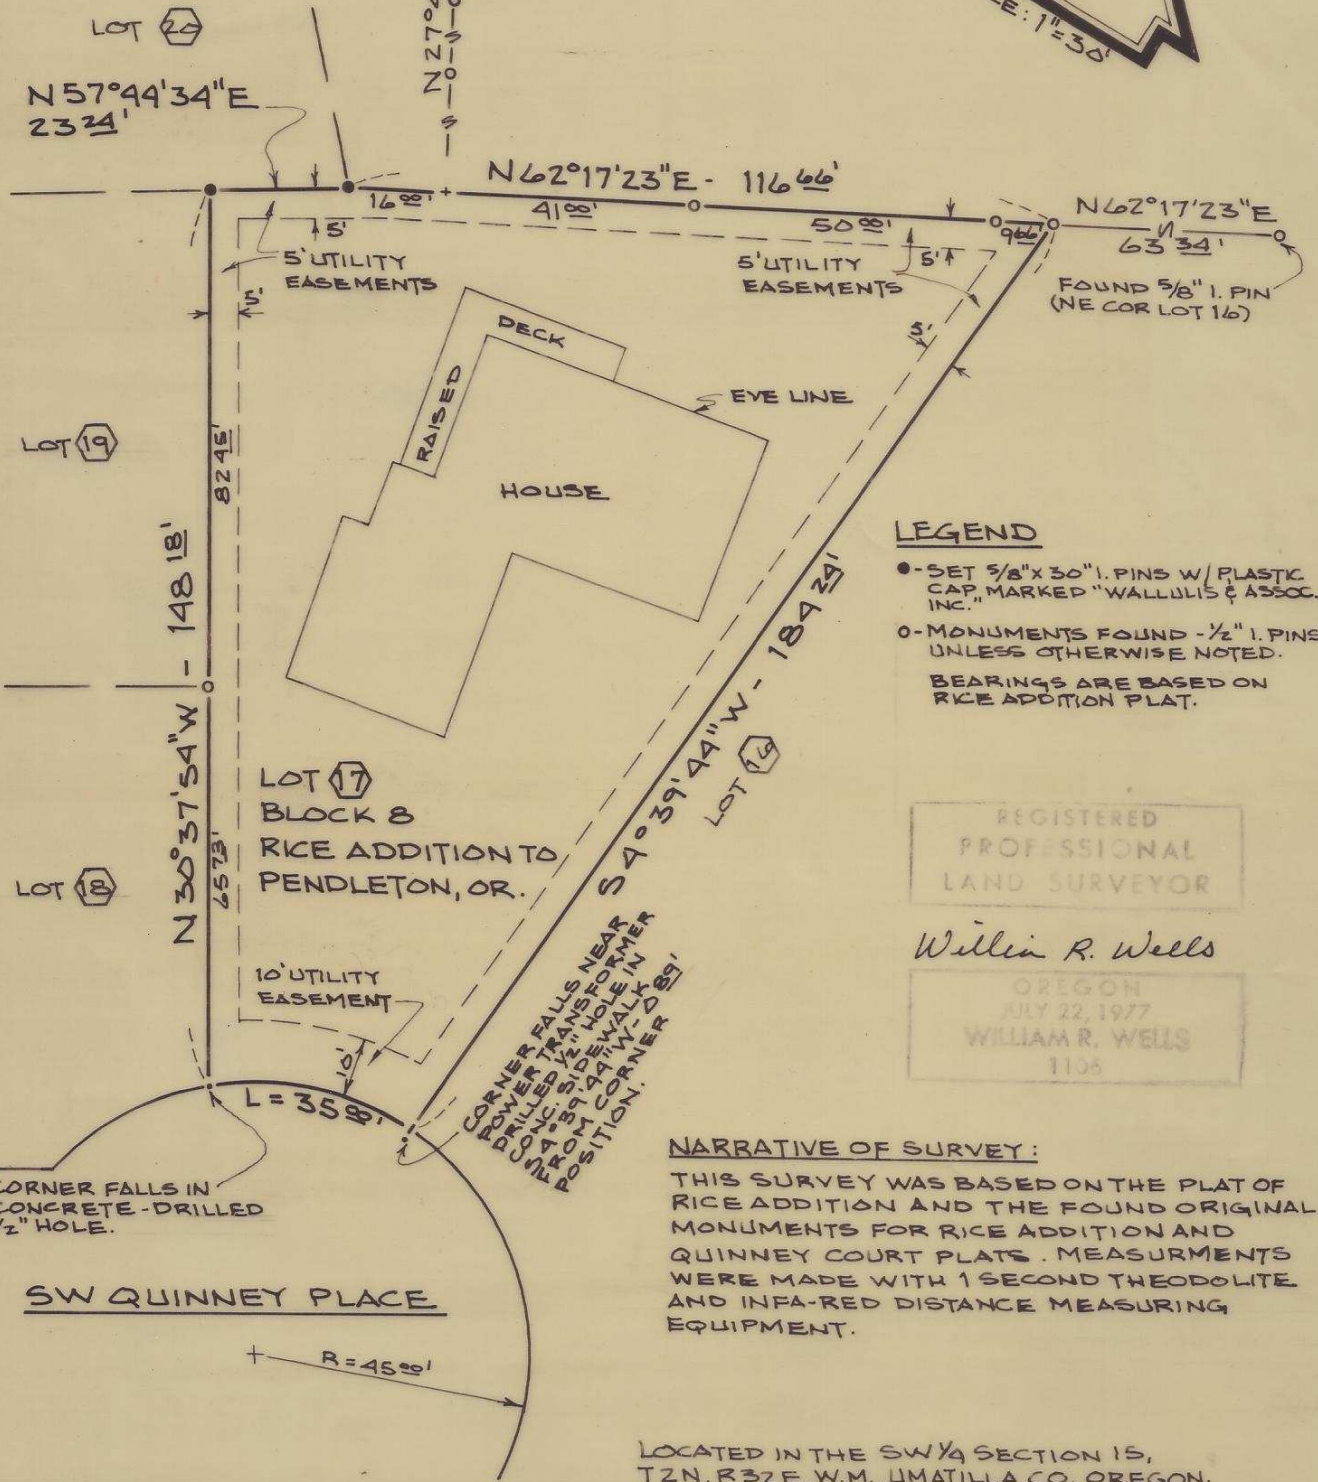

BRUING 40-22-3381

PROJ
ELIZABETH & JAMES MFAUSLAN

TITLE
SURVEY

WALLULIS & ASSOCIATES, INC.
ENGINEERING & PLANNING

PENDLETON
276-1598 OREGON

SCALE
1" = 30'

DATE
10-20-82

NO.
82-117

11-82 BLS 82-128-Ax