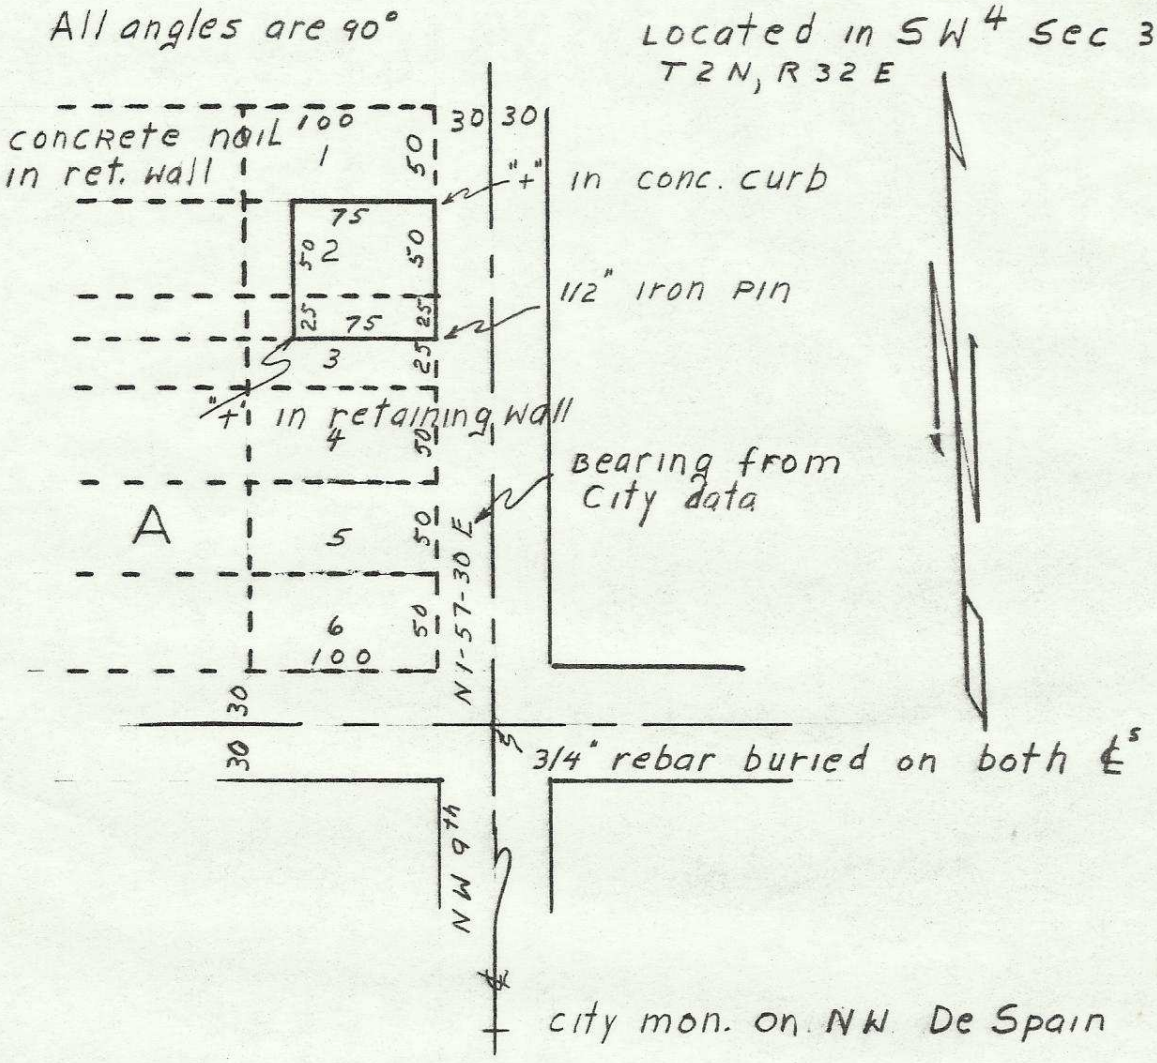

SURVEY IN BLOCK A OF LIVERMORE ADDITION (SW QUARTER OF SEC. 3 T. 4 N., R. 32 E) TO SET THE CORNERS OF THE FOLLOWING DESCRIBED PARCEL; E. 75 FEET OF LOT 4 & THE E. 75 FEET OF THE N. 25 FEET OF OF LOT 3 OF SAID ADDITION.

STARTED AT DESCRIBED IRON PIN; THENCE ALONG C-L DISTANCES OF 205 & 280 FEET. I TURNED 90° ANGLES FROM EACH POINT AND PLACED MONUMENTS AS SHOWN AT DISTANCES SHOWN.

RECEIVED BY
Umatilla County Surveyor
Date 5/18/84
Rec'd by B. Cochran
No. 84-55-AX

REGISTERED PROFESSIONAL LAND SURVEYOR

Wayne O. Harris

OREGON
MAY 6, 1975
WAYNE O. HARRIS
346

WAYNE HARRIS CO. INC.

SURVEY FOR: JOE RODEN ESTATE

LOCATION: BLOCK A LIVERMORE ADD.

CHECK BY Work

DATE: 5-17-84

JOB

SCALE: 1"-100

DRNG NO 84428

84-53-Ax