

NARRATIVE: The purpose of this survey is to stake two 2 Acre ± parcels which are part of the East 220.50 feet of the west 627.50 feet of the SE 1/4 SW 1/4 of sec. 34, T5N, R28E, W.M. which were recently described by PIONEER TITLE. I also staked the NE cor. of said west 627.50 feet.


The bearings & survey are based on Ivan Drivers 1975 sur. for M. Hamilton.

- 1" iron pipes set by Driver in 1975
- (000) of record either Deed or Driver
- 1/2" x 24" I. rod set with alum tag stamped 951

SCALE: 1" = 200'



Bearing Base Ivan Driver's 1975 sur. for M. Hamilton

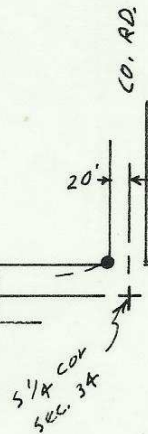

REGISTERED
PROFESSIONAL
LAND SURVEYOR

Dennis Edwards

OREGON
JULY 12, 1971
G. DENNIS EDWARDS
951

RECEIVED BY

Umatilla County Surveyor

Date _____

Rec'd by _____

No. 85-165-Ax

SURVEY FOR JOHN FREDRICKSON
IN SW 1/4 Sec. 34, T5N, R28E, W.M.
UMATILLA CO., OREGON

5/16/85 Job # 58505028

EDWARDS SURVEYING P.O. Box 763
567-3336 HERMISTON, OREGON