

100.00

30.00

P-K nail w/ Bottle Cap

90.00

0.65 set back

0.62 Wall Thickness

99.65 Building length

Building Line is on R<sub>2</sub>

LOT 7

150.00

LOT 8

LOT 9

Block 42

RESERVATION ADDITION TO  
THE CITY OF PENDLETON, OREGON

100.00


100.00

30.00

P-K nail w/ Bottle cap

The roughness of the stone veneer extends approx. 2 inches in to street right of way at the most.

17th ST. S.W.

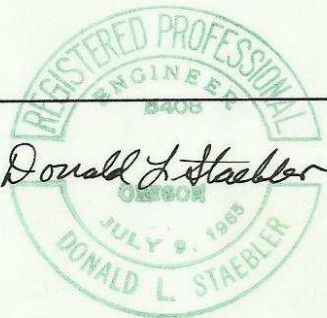

Donald L. Staebler

2N32 10CB

PLOT PLAN SURVEY FOR CHARLES F. MONTEE

SCALE: 1" = 20' 11-10-71

DONALD L. STAEBLER  
CONSULTING ENGINEER  
P.O. Box 91  
PENDLETON, OREGON

99-218-Ax

S.W. EMIGRANT AVE.