

N 89° 52' E 1318.44

COUNTY ROAD No. 309, 1574

Found Rock

N 89° 49' 10" E 2012.10

STATE LINE

S 87° 35' 36" W 3333.49

LOT 1


LOT 2

LOT 3

Concrete Spotline Marker

Well

CENTER OF SECTION 13  
T4N, 6 N; R33E, 11 W

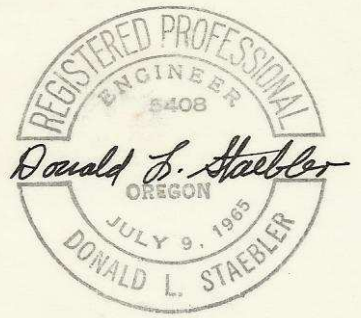

99-227-Ax

WATER RIGHT SURVEY FOR  
E. C. BURLINGAME JR.  
IRRIGATION WELL

DRW BY: D.L.S. DATE: 2-2-66 SCALE: 1" = 400'

WALLULIS & STAEBLER  
CONSULTING ENGINEERS  
213 S.W. EMIGRANT  
P.O. BOX 91  
PENDLETON OREGON