
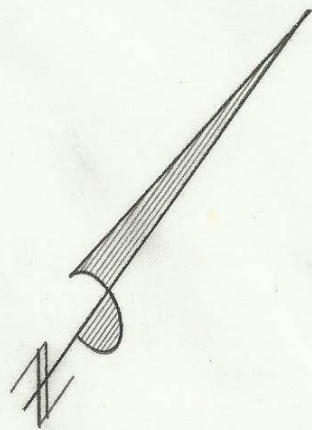


REGISTERED
OREGON
LAND SURVEYOR

Wayne O. Harris

MAY 6, 1955
WAYNE O. HARRIS
346

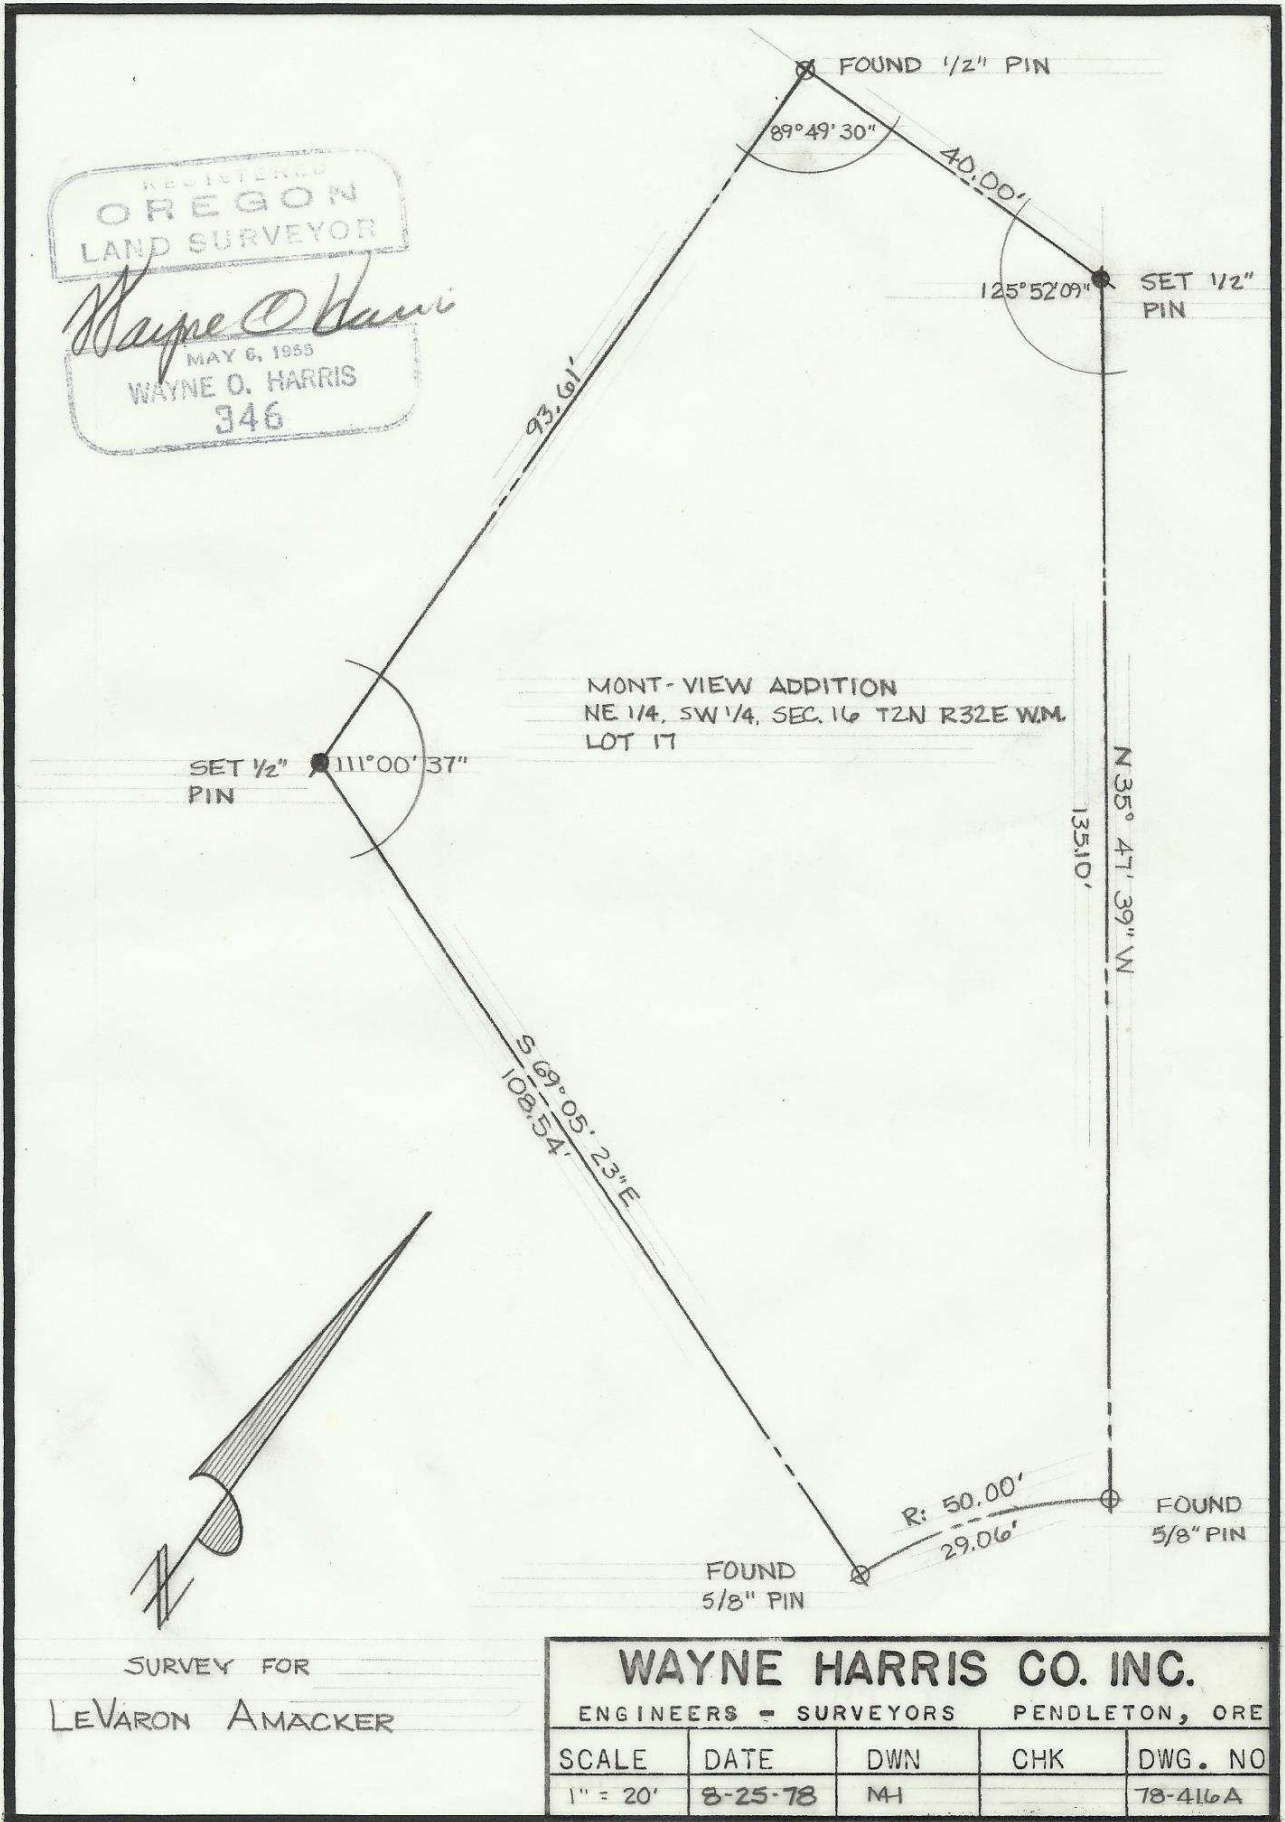

SURVEY FOR
LEVARON AMACKER

WAYNE HARRIS CO. INC.				
ENGINEERS - SURVEYORS PENDLETON, ORE				
SCALE	DATE	DWN	CHK	DWG. NO
1" = 20'	8-25-78	MH		78-416A

203216 CA
02-233-A8