


LEGEND


- 1/2"x24" IRON PINS
- IMPOSSIBLE TO SET PINS
- - - 4' Sewer easement

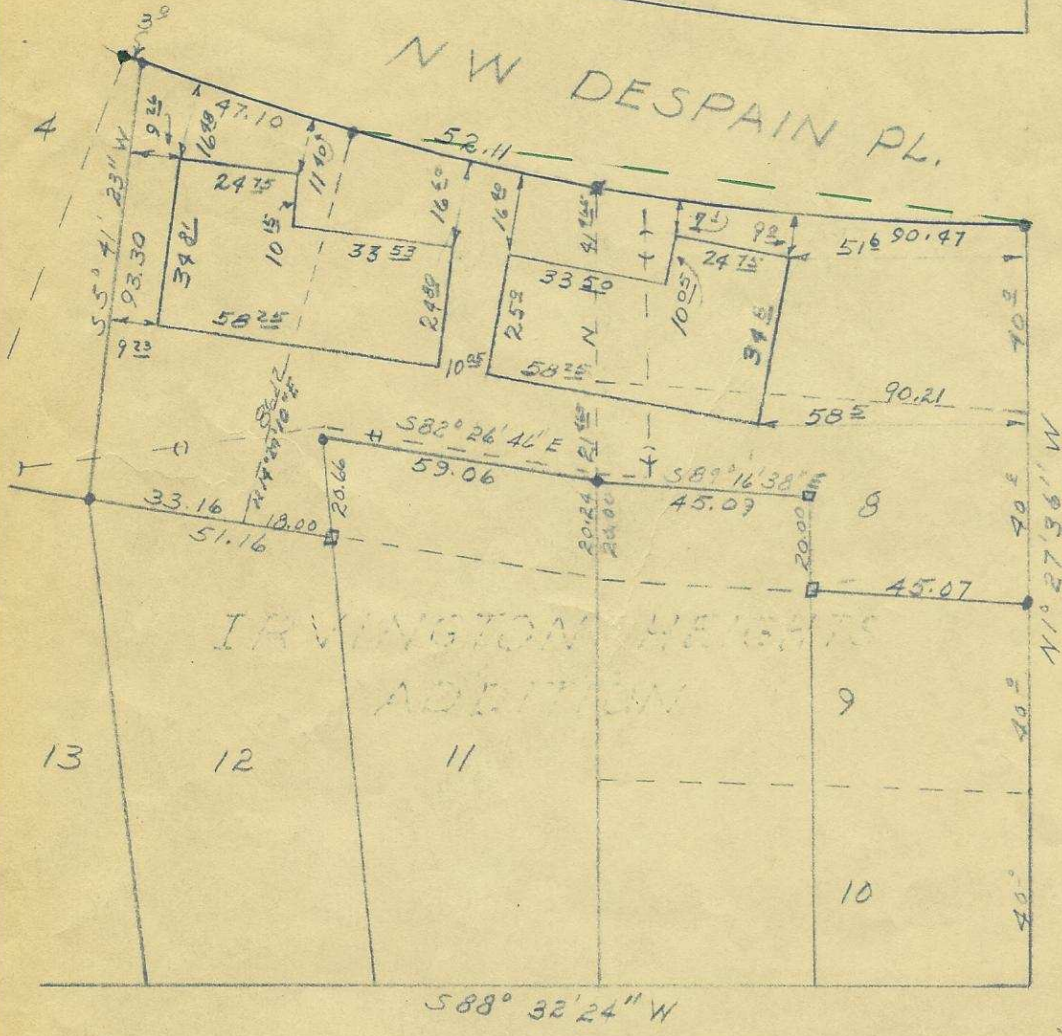

N.W. 1/2
N.W. 1/4

N.W. DESPAIN

210' 26' 10"
82' 32' 24"
100' 58' 34"
179' 54' 37"
114' 0' 14"
111'
N 65° 45' 49" W
Chord 6mg

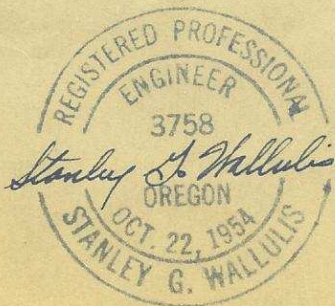

2N32 03 CD

SCALE: C.A.E. 1" = 40'	DATE: 6-12-56
WALL AND TENNESON Engineers	
The Dalles	Oregon

04-176-Ax