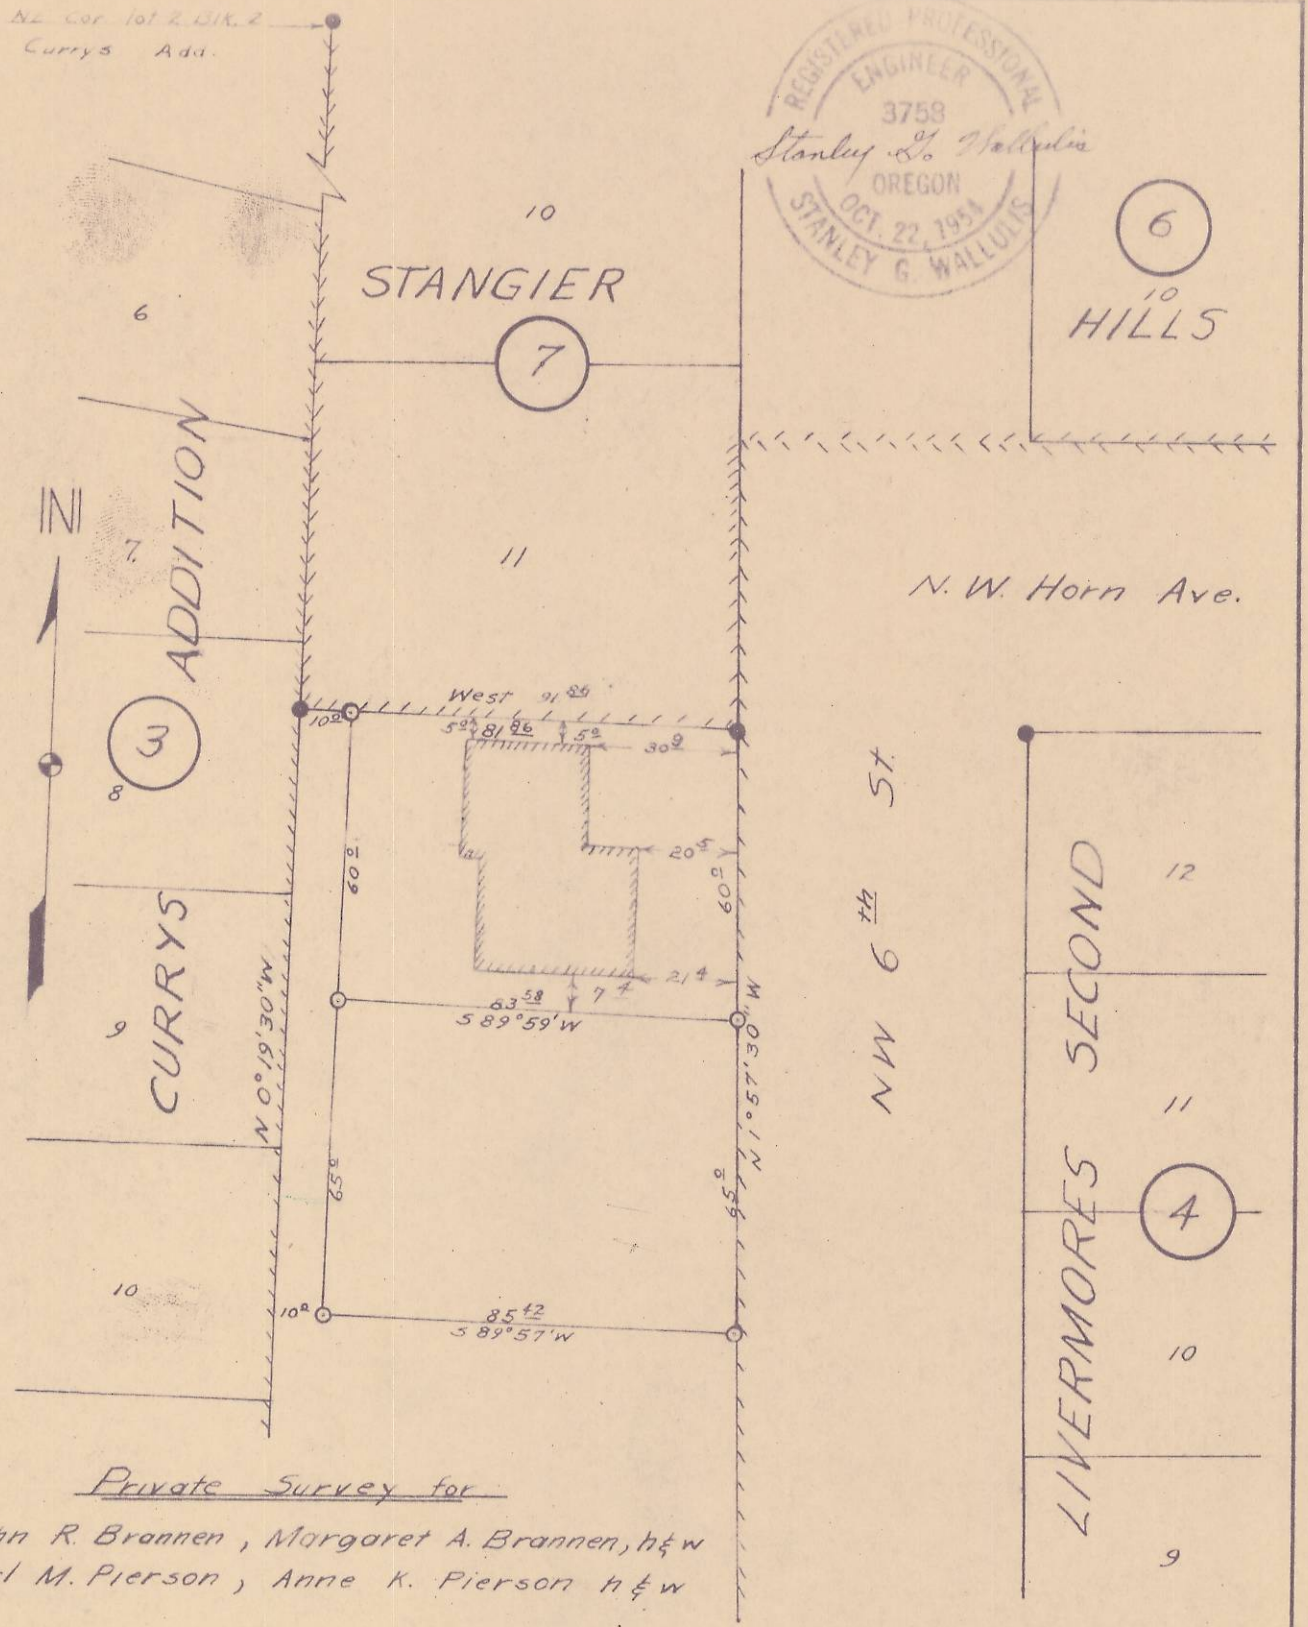

Private Survey for

John R. Brannen, Margaret A. Brannen, h & w
Earl M. Pierson, Anne K. Pierson h & w

Legend

Points Found ●
Points Set ○

2N 32 03 DA

SCALE 1" = 40'	DATE: Mar. 12, 1955

WALL AND TENNESON
Engineers
Pendleton Oregon

04-184-AL