


KERNON B TENNESON & ASSOCIATES
7-5-56

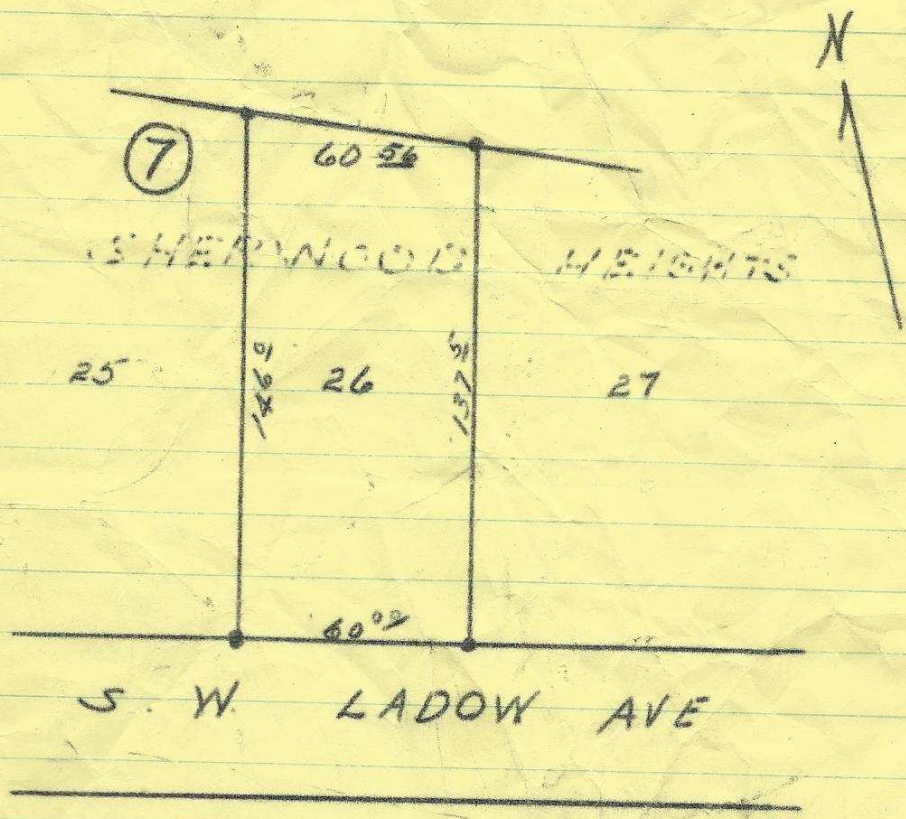

• 1/2" x 24" IRON PINS

