


TYLER AVENUE

5' UTILITY EASEMENT
ADJACENT TO ALL LOT LINES

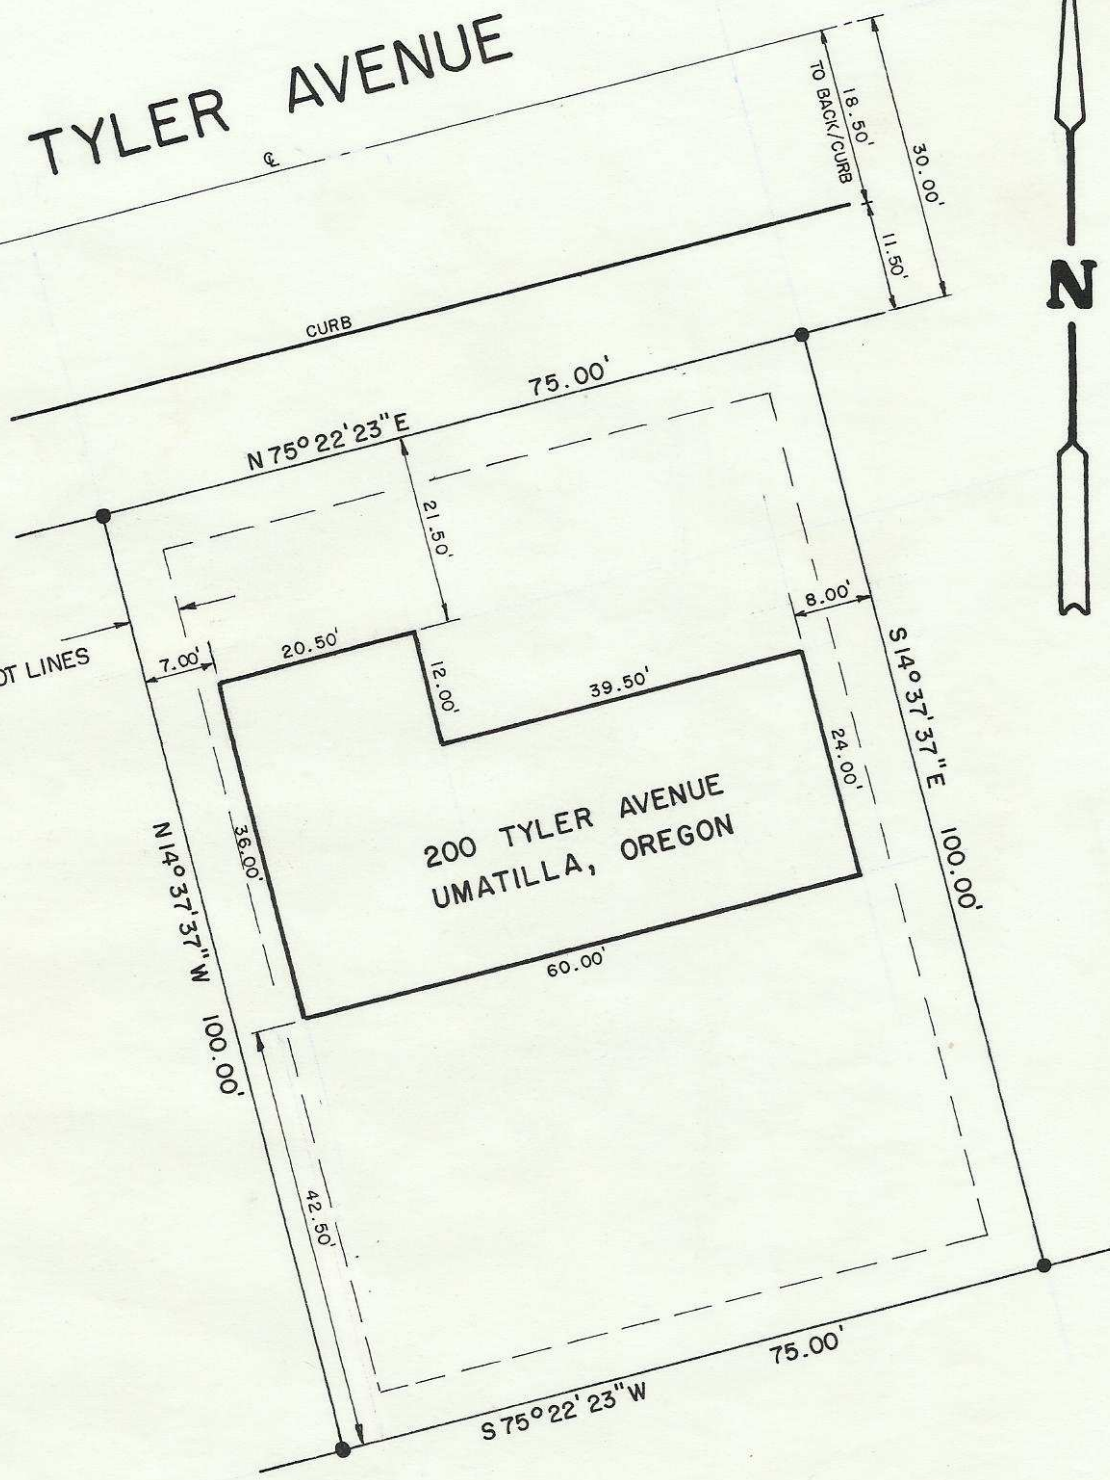


TSN 28 20BB

NORPA DEVELOPMENT, INC. HERMISTON, ORE.

LOT SURVEY

LOT 5, BLOCK 4 CONFORTHS FIRST ADDITION

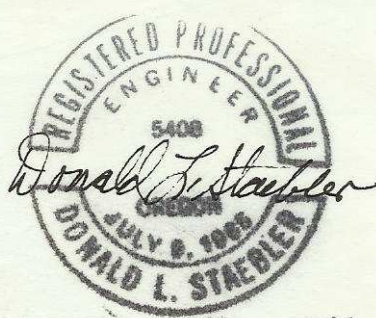

04-204-Ax

DESIGN	D. N.	CHK	D. S.	SCALE	1" = 20'	DATE	8-5-77
DRAFT	D. N.	APP	J.O.	REV			

OF