Map of
Tract located in N.W/4 of N.W/4 of
Sec. 10 T. 2N., R. 33E. W.M. (Umatilla Co. Ore)
Surveyed, staked & platted - May - 1953.
By W. E. O. Criger. Scale: 1" = 100'
For - Mr. Morris Mitchell - R. 2. Box 15 G. Pendleton.
312 - S.W. 21 st. - Ph. 1950

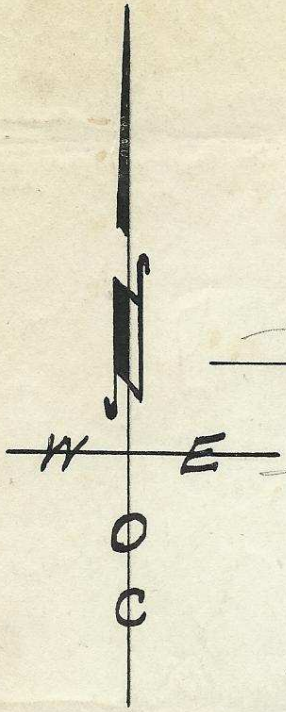

4 3
9 10

East.
434 ft

River.

S. 60 26' W. 343.9'

2 a

434 ft

143 a.

S. 1 00' W - 200'

91.000'

(Bridge)

Game Farm Road.

S. 12 35' W - 152 ft

11 35'

Brass Cap - W.C. 38.52'

North 715'

Raymond Anderson, resident.

401 -

167 a.

Total - 5 10 a

34 43'

S. 47 0 18' W - 541 ft

(Also # 893)

47 18'

Co Rd # 885 - 60' Wide -

RS - 893 - So. Pkg.

Easements - P. P. + L.
Bk 185 - P. 315
~~Bk 185 - P. 357~~

(Add 4 36')
= 27 5 E. Co.
(42.5)

REGISTERED PROFESSIONAL ENGINEER
1497
W E O Criger
OREGON
MAR. 9, 1931
W. E. O. CRIGER

06-75-Ax