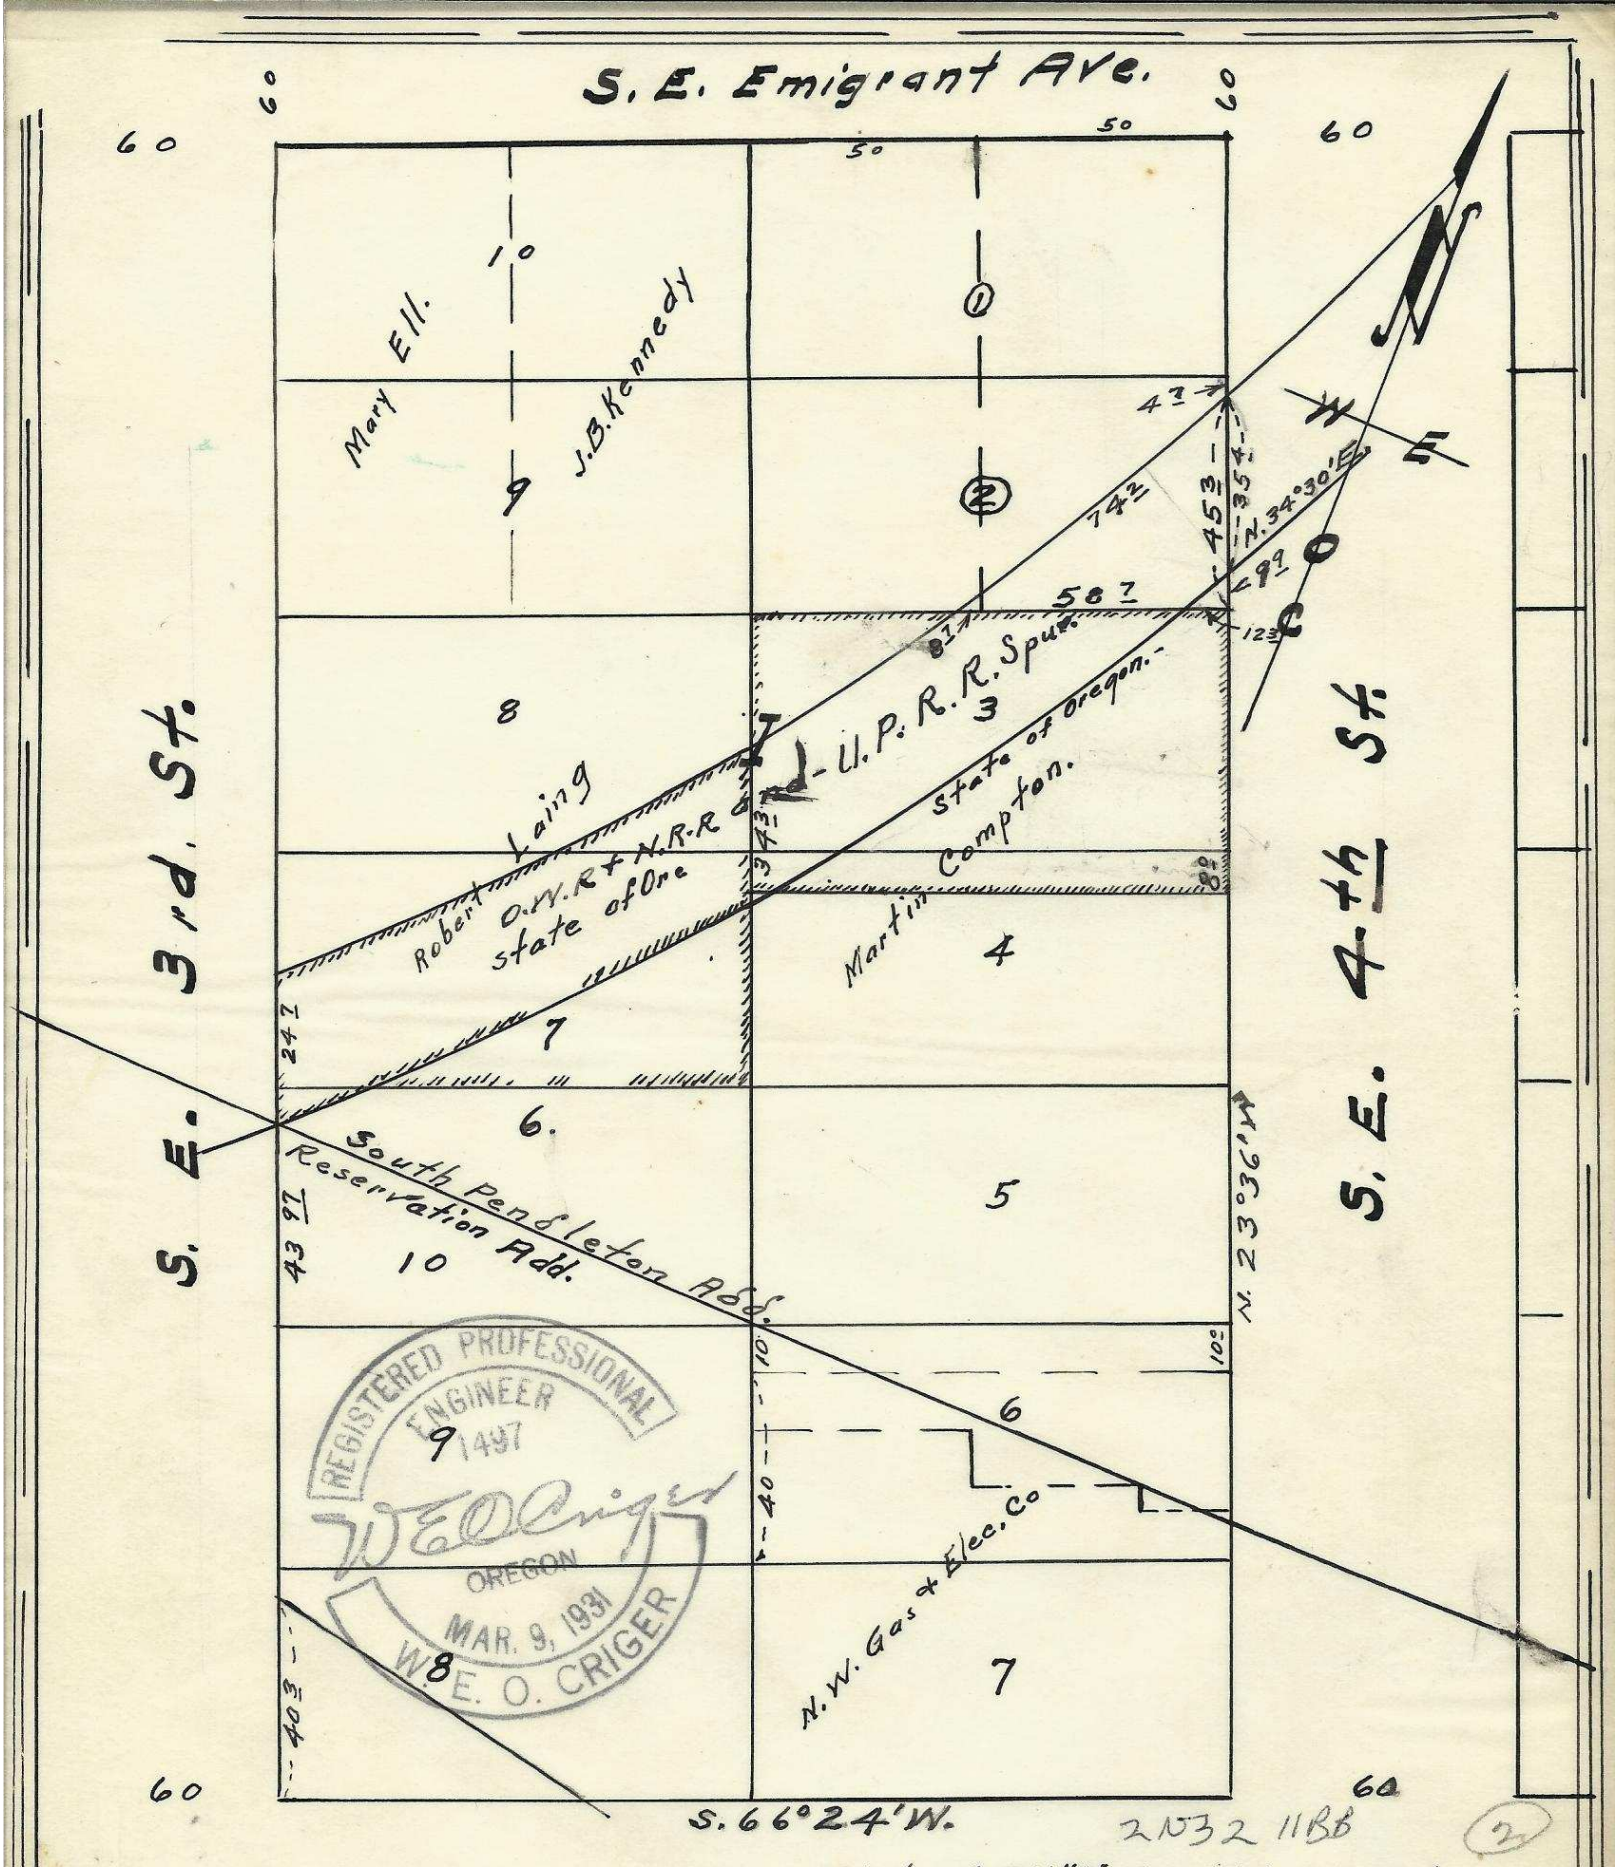

2N32 11BB (2)

Plat of Blk. 'I' of South Pendleton Addition to the Town, now city of Pendleton, Oregon. Surveyed, staked and platted, Jan. 1951 By - W. E. O. Criger.

Scale: 1 in. = 40 Ft.

Bk-130-P. 527. - Ord. No. 1662 - (1936) Brandhagen. Deed Apr. 24-

See J. M. Devers.

June 24-1936.

06-168-Ax