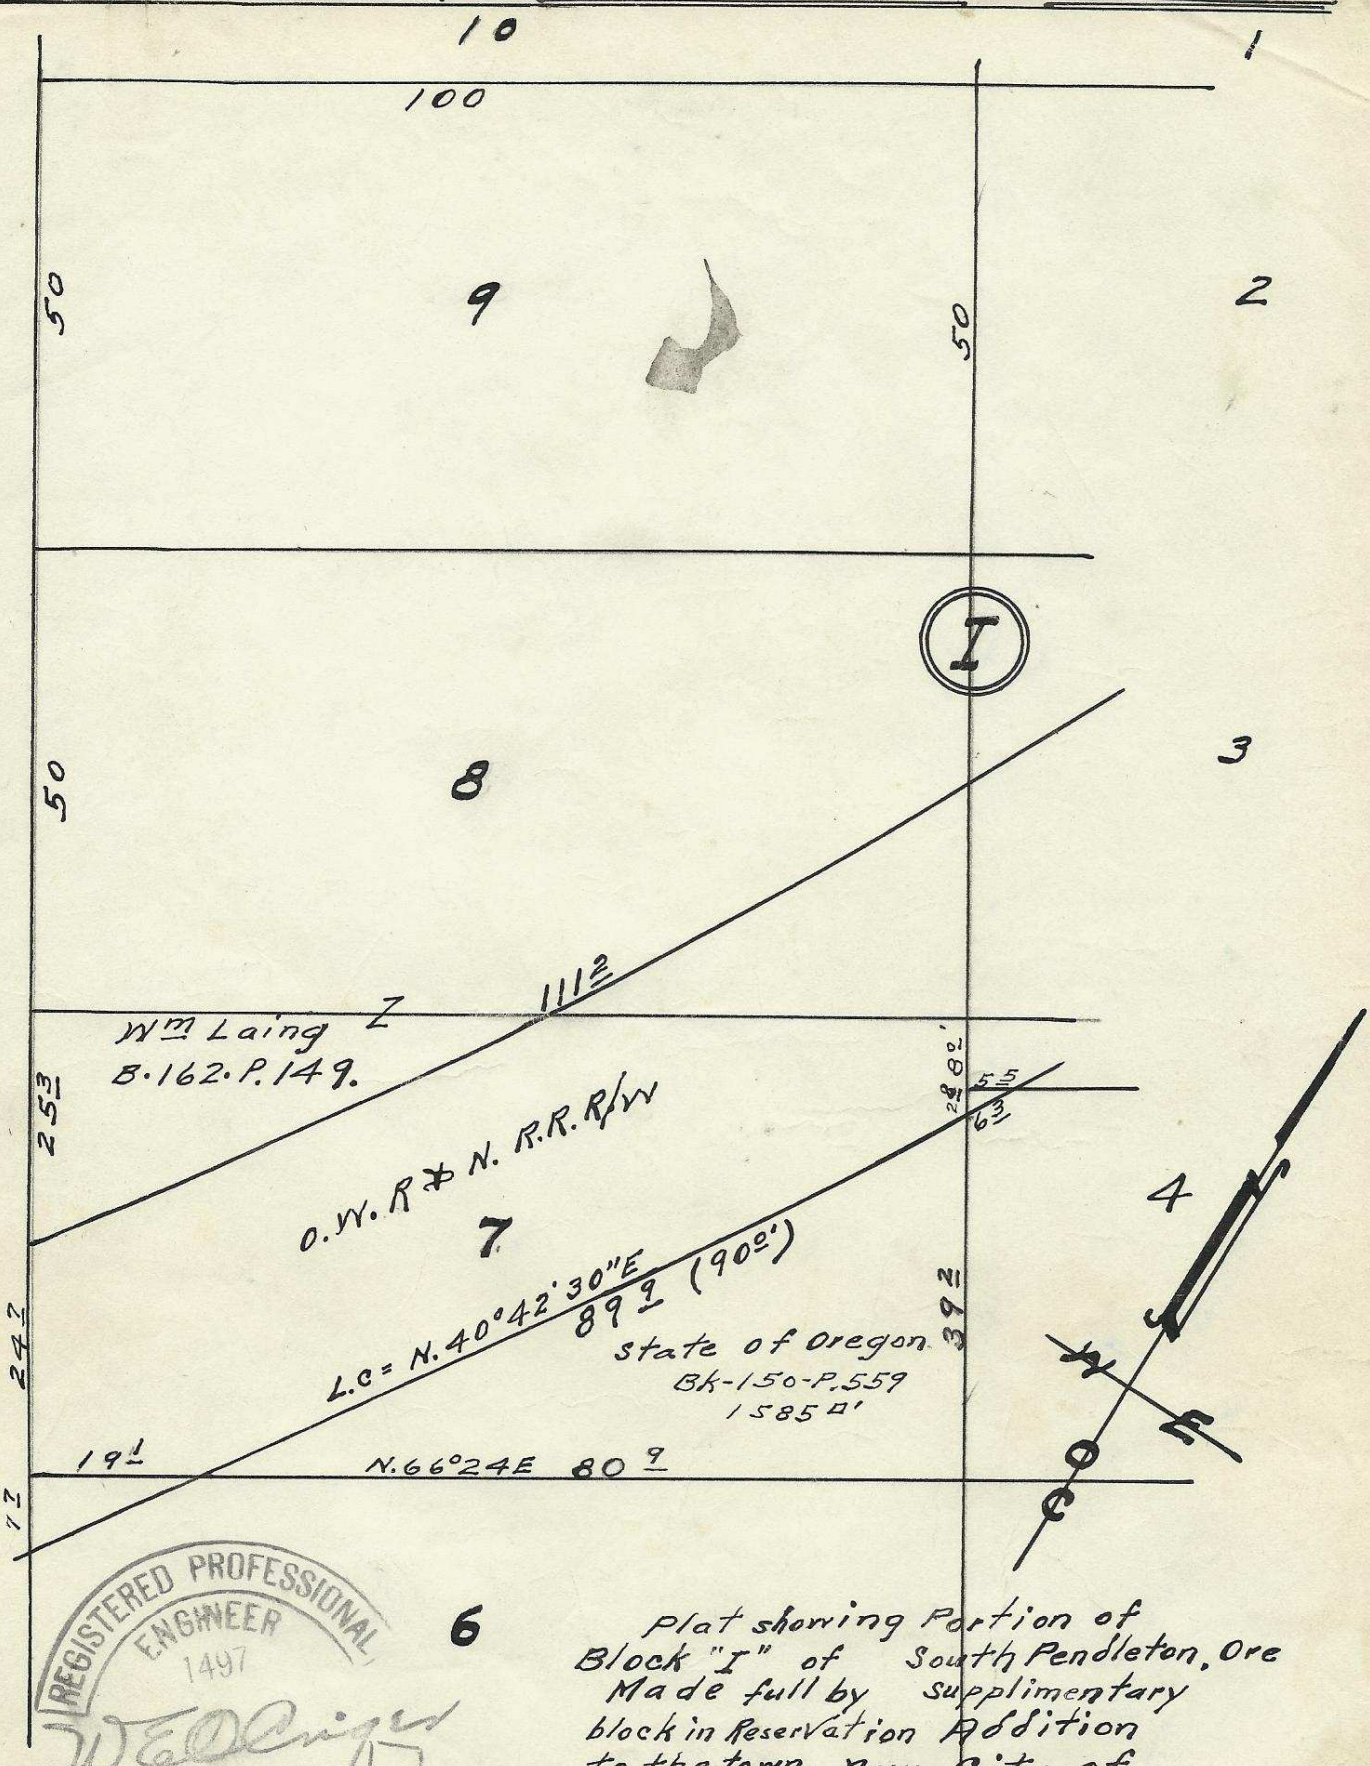

REGISTERED PROFESSIONAL ENGINEER 1497 W.E.O. Criger OREGON MAR. 9, 1931 W. E. O. CRIGER

Plat showing Portion of Block "I" of South Pendleton, Ore Made full by supplimentary block in Reservation Addition to the town, Now City of Pendleton, Oregon. surveyed, staked & platted By W.E.O. Criger. Scale 1" = 20'

2N32-11BB

06-169-AX

BK-160-P. 9+10-Deed Records. (Sheow Nom Lee)