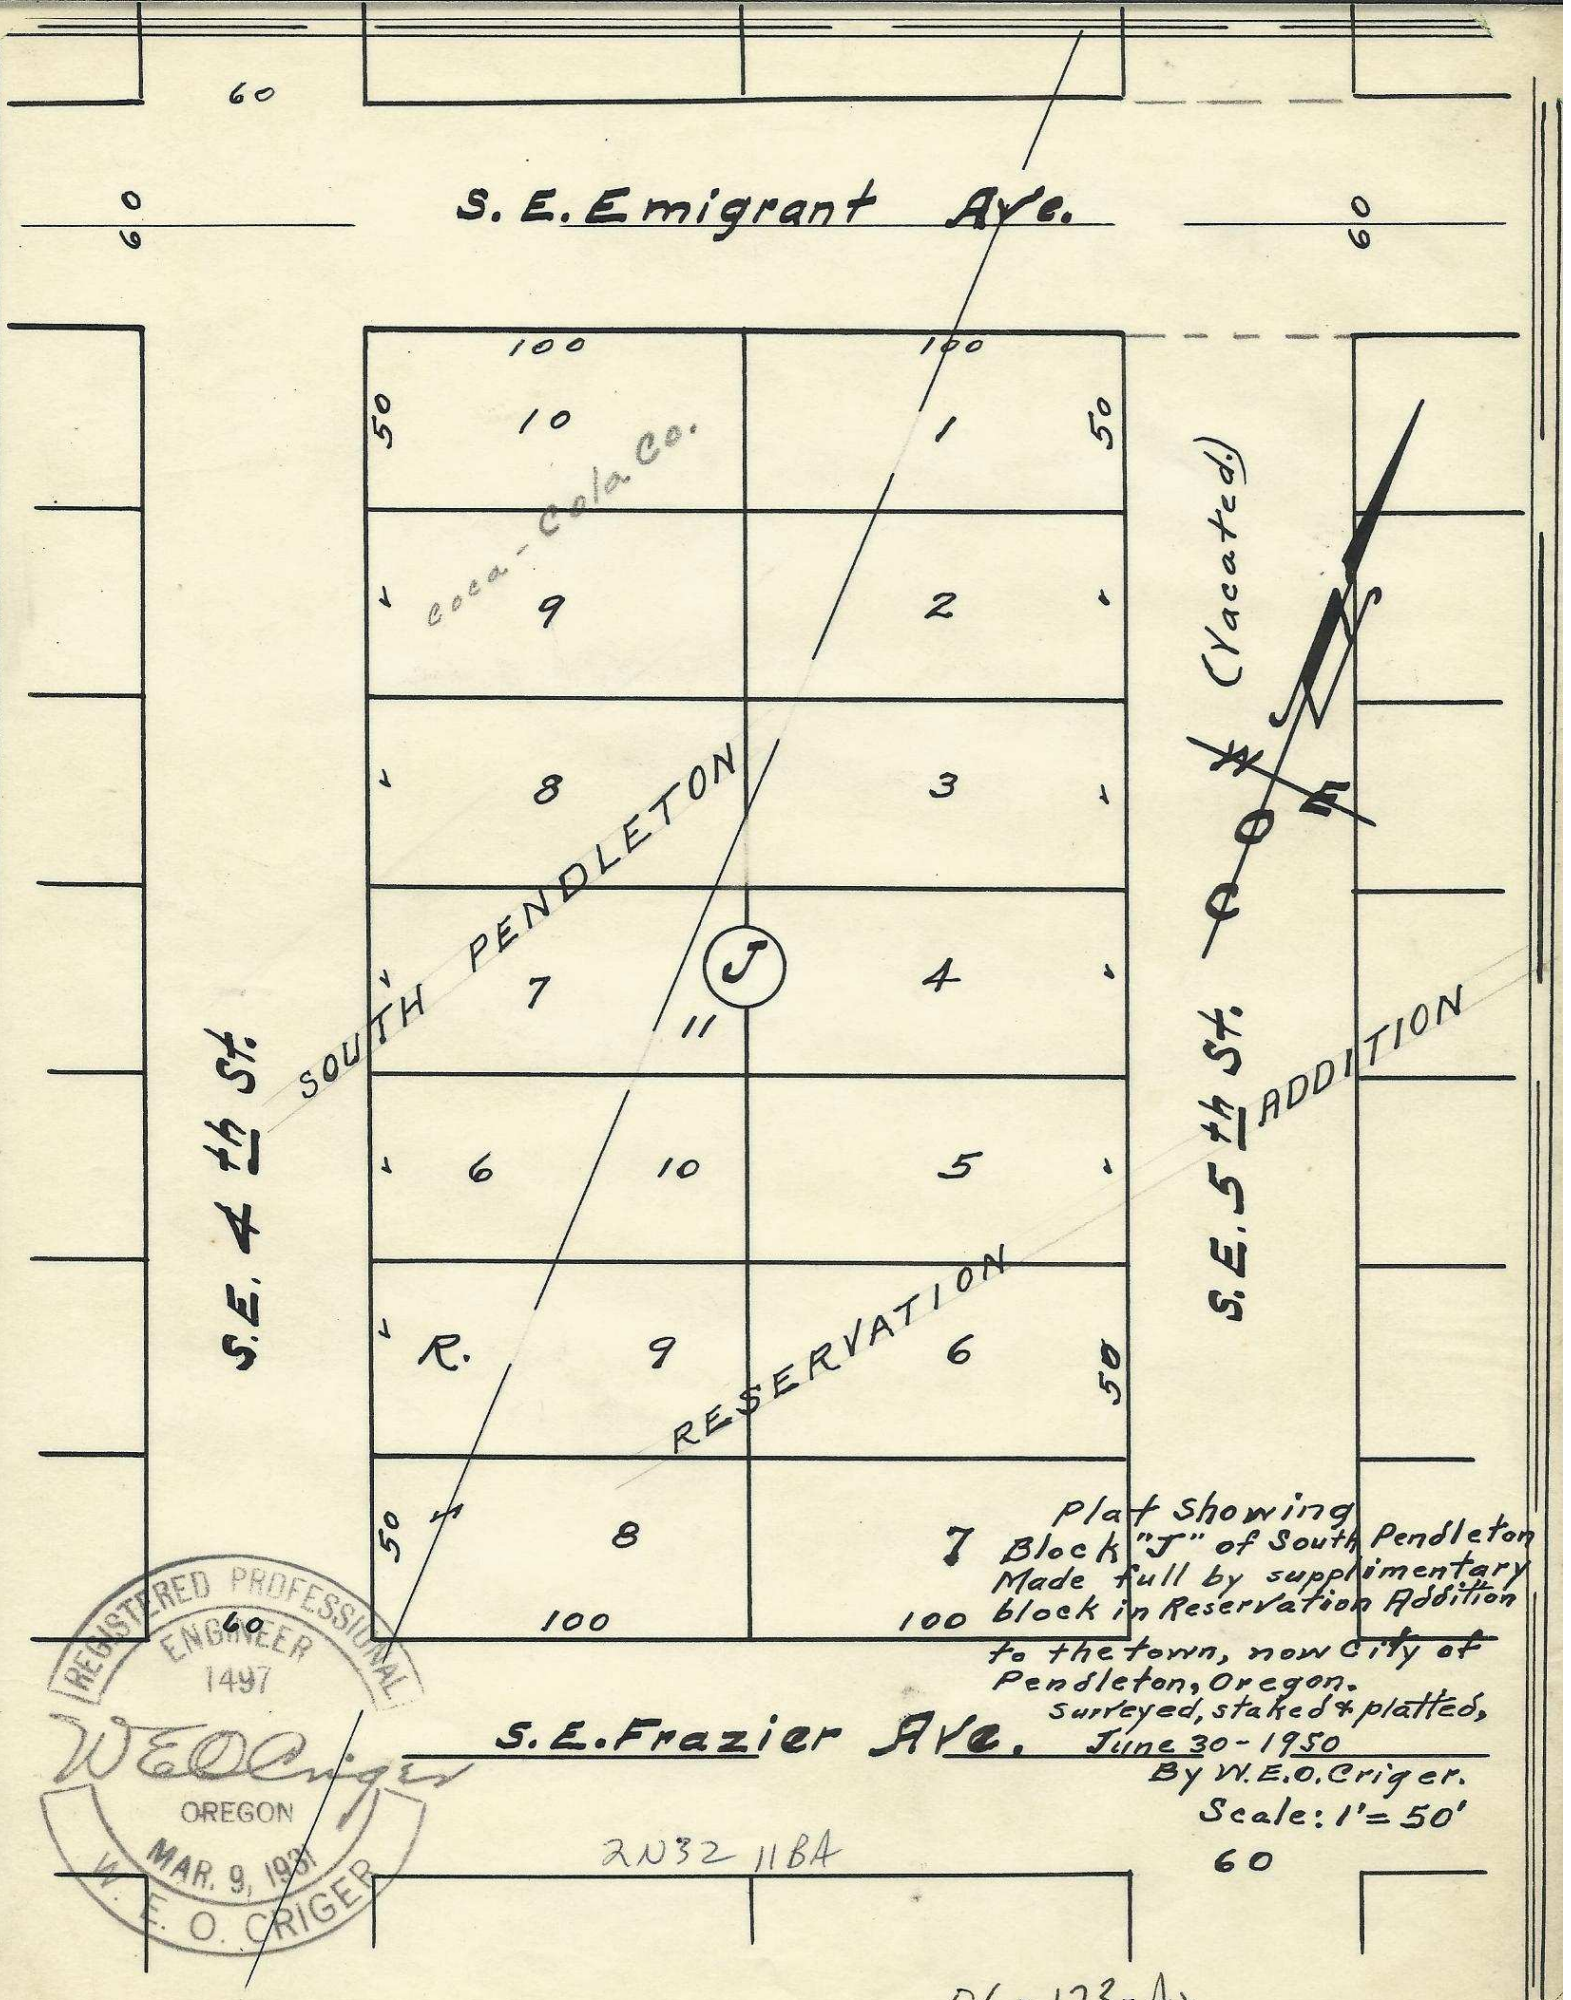
S. E. Emigrant Ave.
60
60
60
100
100
50
10
1
50
Coca-Cola Co.
9
2
8
3
SOUTH PENDLETON
7
11
J
4
6
10
5
R.
9
6
50
RESERVATION
50
8
7
100
100
S.E. 4th St.
S.E. 5th St. (Vacated)
ADDITION
S. E. Frazier Ave.
60
Plat Showing
Block "J" of South Pendleton
Made full by supplimentary
block in Reservation Addition
to the town, now City of
Pendleton, Oregon.
Surveyed, staked & platted,
June 30 - 1950
By W. E. O. Criger.
Scale: 1" = 50'
60
REGISTERED PROFESSIONAL ENGINEER
1497
W.E.O. Criger
OREGON
MAR. 9, 1961
W. E. O. CRIGER
2N32 11BA
06-173-A