


S.W. Court Place

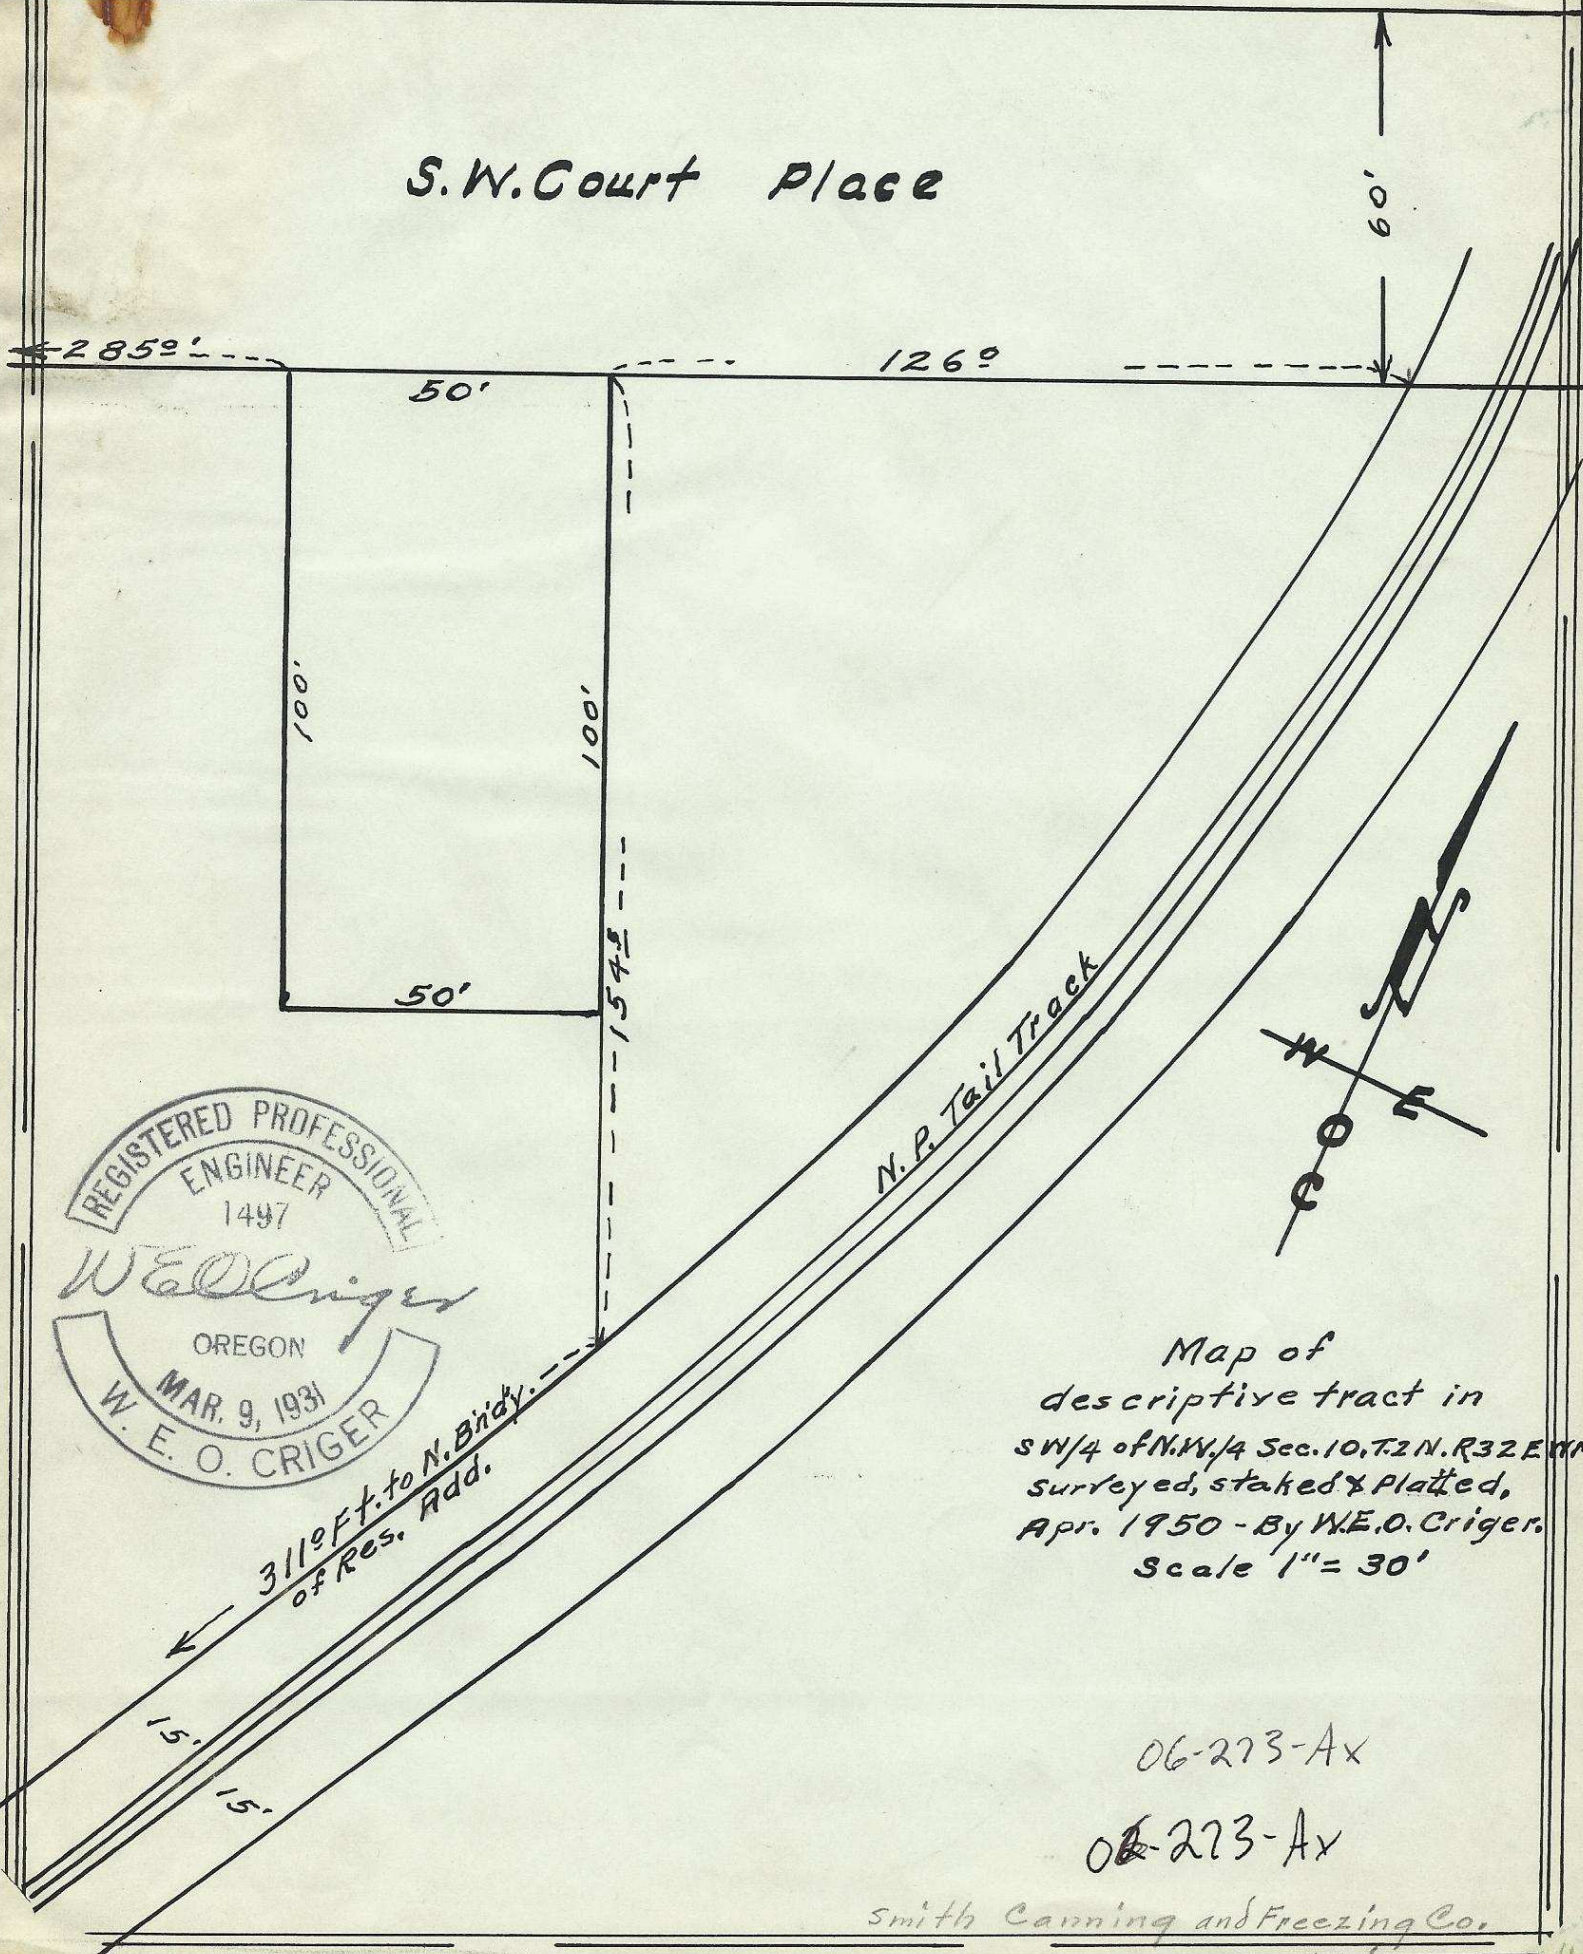

60'

2853'

126°

50'


100'

100'

50'

154'

N.P. Tail Track

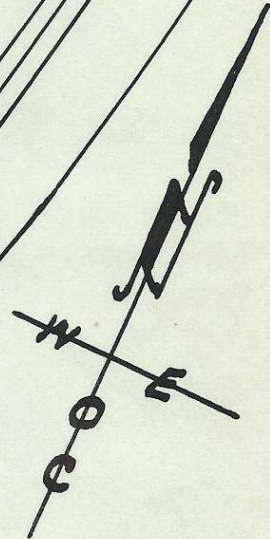

311' Ft. to N. Bldg. of Res. Add.

Map of
descriptive tract in
SW/4 of N.W. 1/4 Sec. 10, T2N, R32E, M1W
surveyed, staked & Platted,
Apr. 1950 - By W.E.O. Criger.
Scale 1" = 30'

06-273-Ax

~~06-273-Ax~~