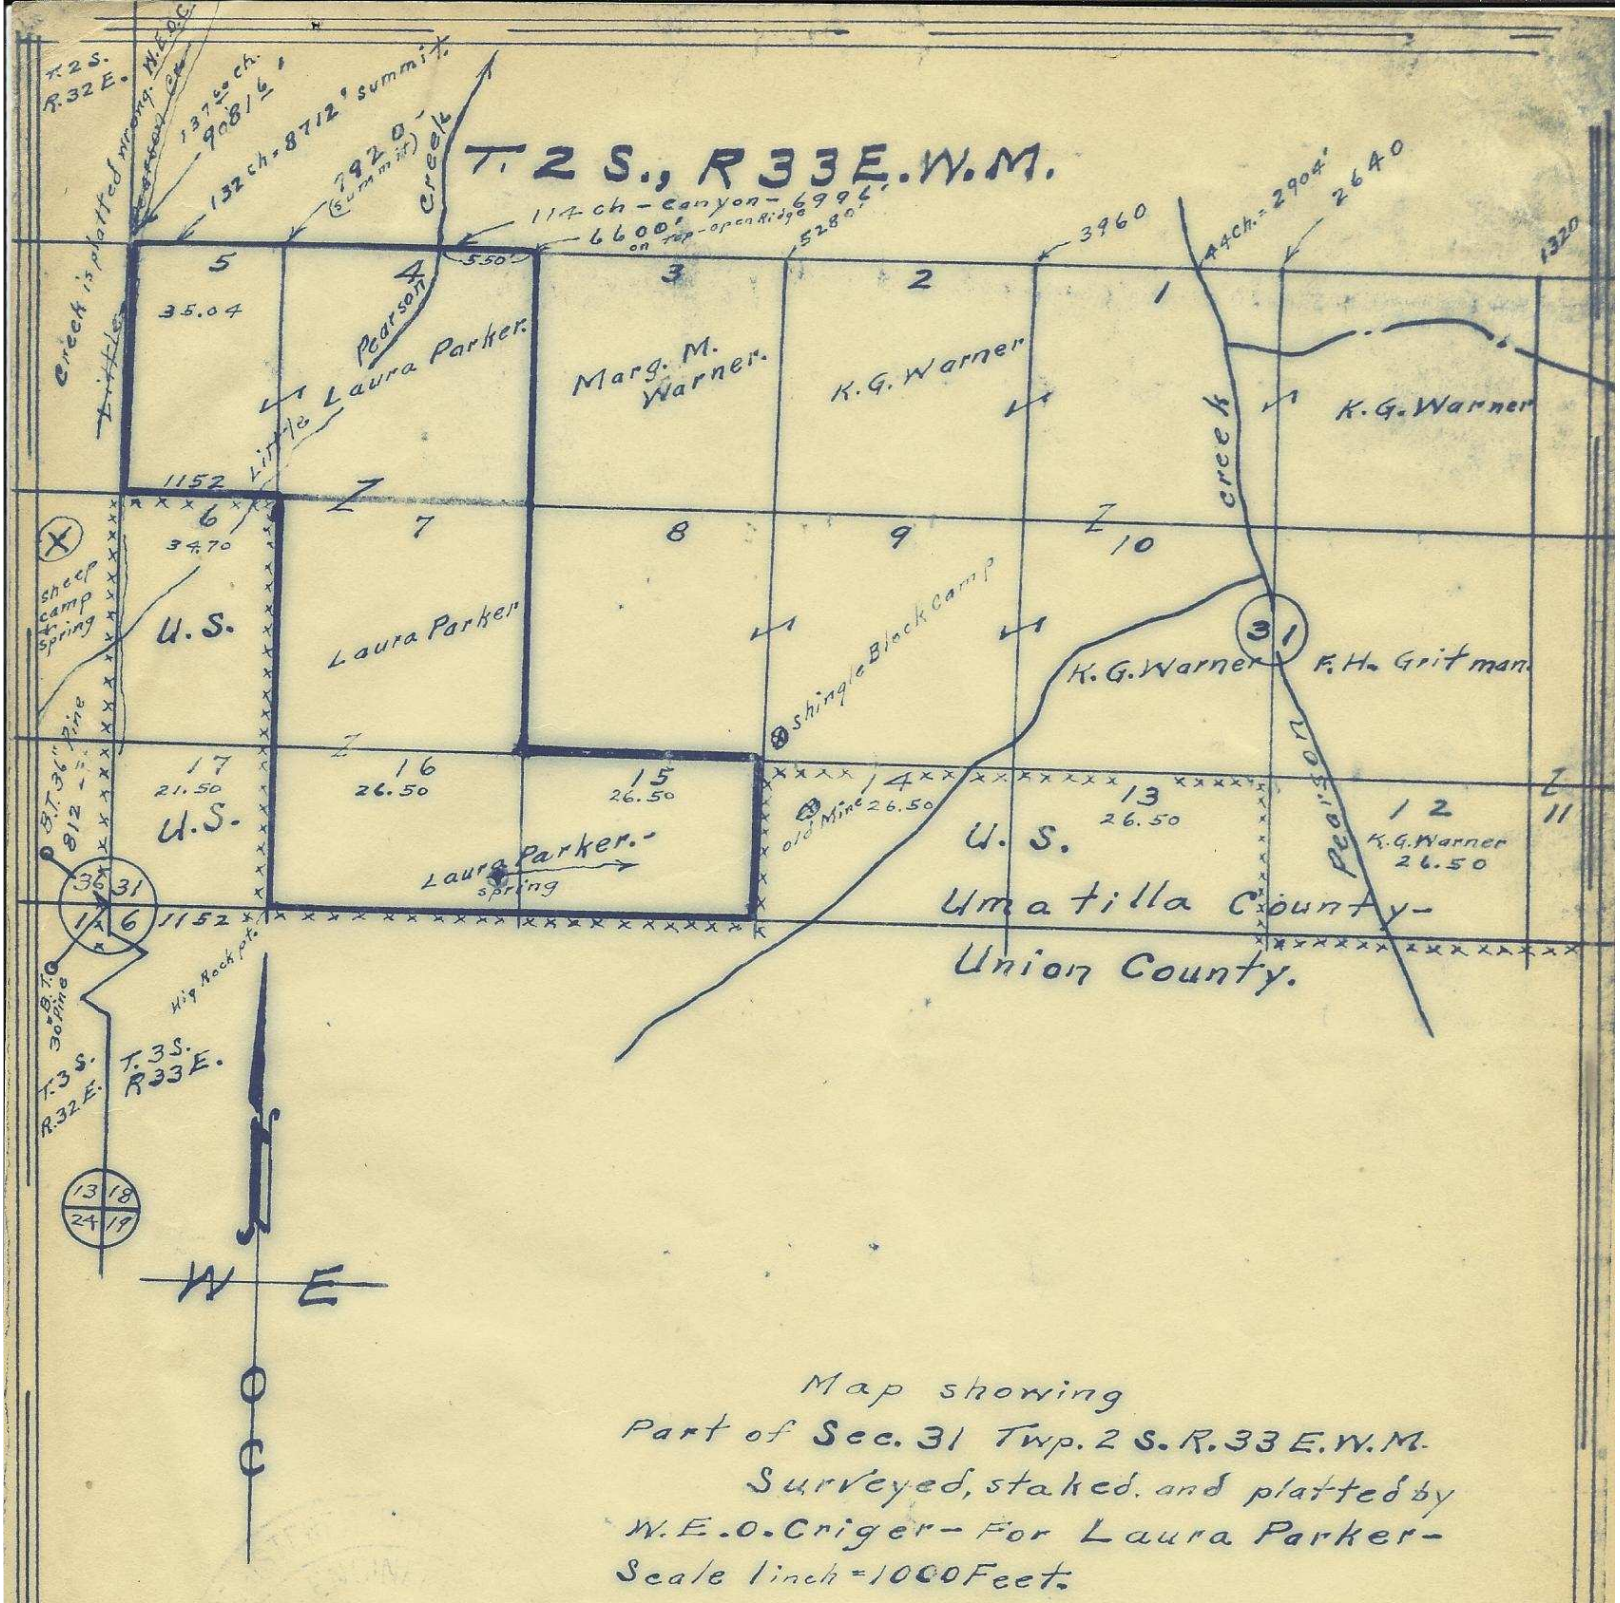

Map showing
Part of Sec. 31 Twp. 2 S. R. 33 E. W.M.
Surveyed, staked and platted by
W. E. O. Criger - For Laura Parker -
Scale 1 inch = 1000 Feet.

06-366-A2

Note:
U.S.G.S. Field Notes. 1869 - Sec. 31. T. 2 S., R. 33 E. W.M.
N. Line - W. from N.E. Corner of Sec. 31.

44.00 ch. = 2904 Ft. Pearson Creek.
106.00 " = 6996 Ft. Summit.
114.00 " = 7526 Ft Canyon. -
132.00 " = 8712 " Summit. -
137.60 " = 9081.6 " S.W. Cor. Sec. 30 - (N.W. Cor. S. 31) on Twp. Line -

(4)

See Book 158-P.79
Umatilla Deed Records.