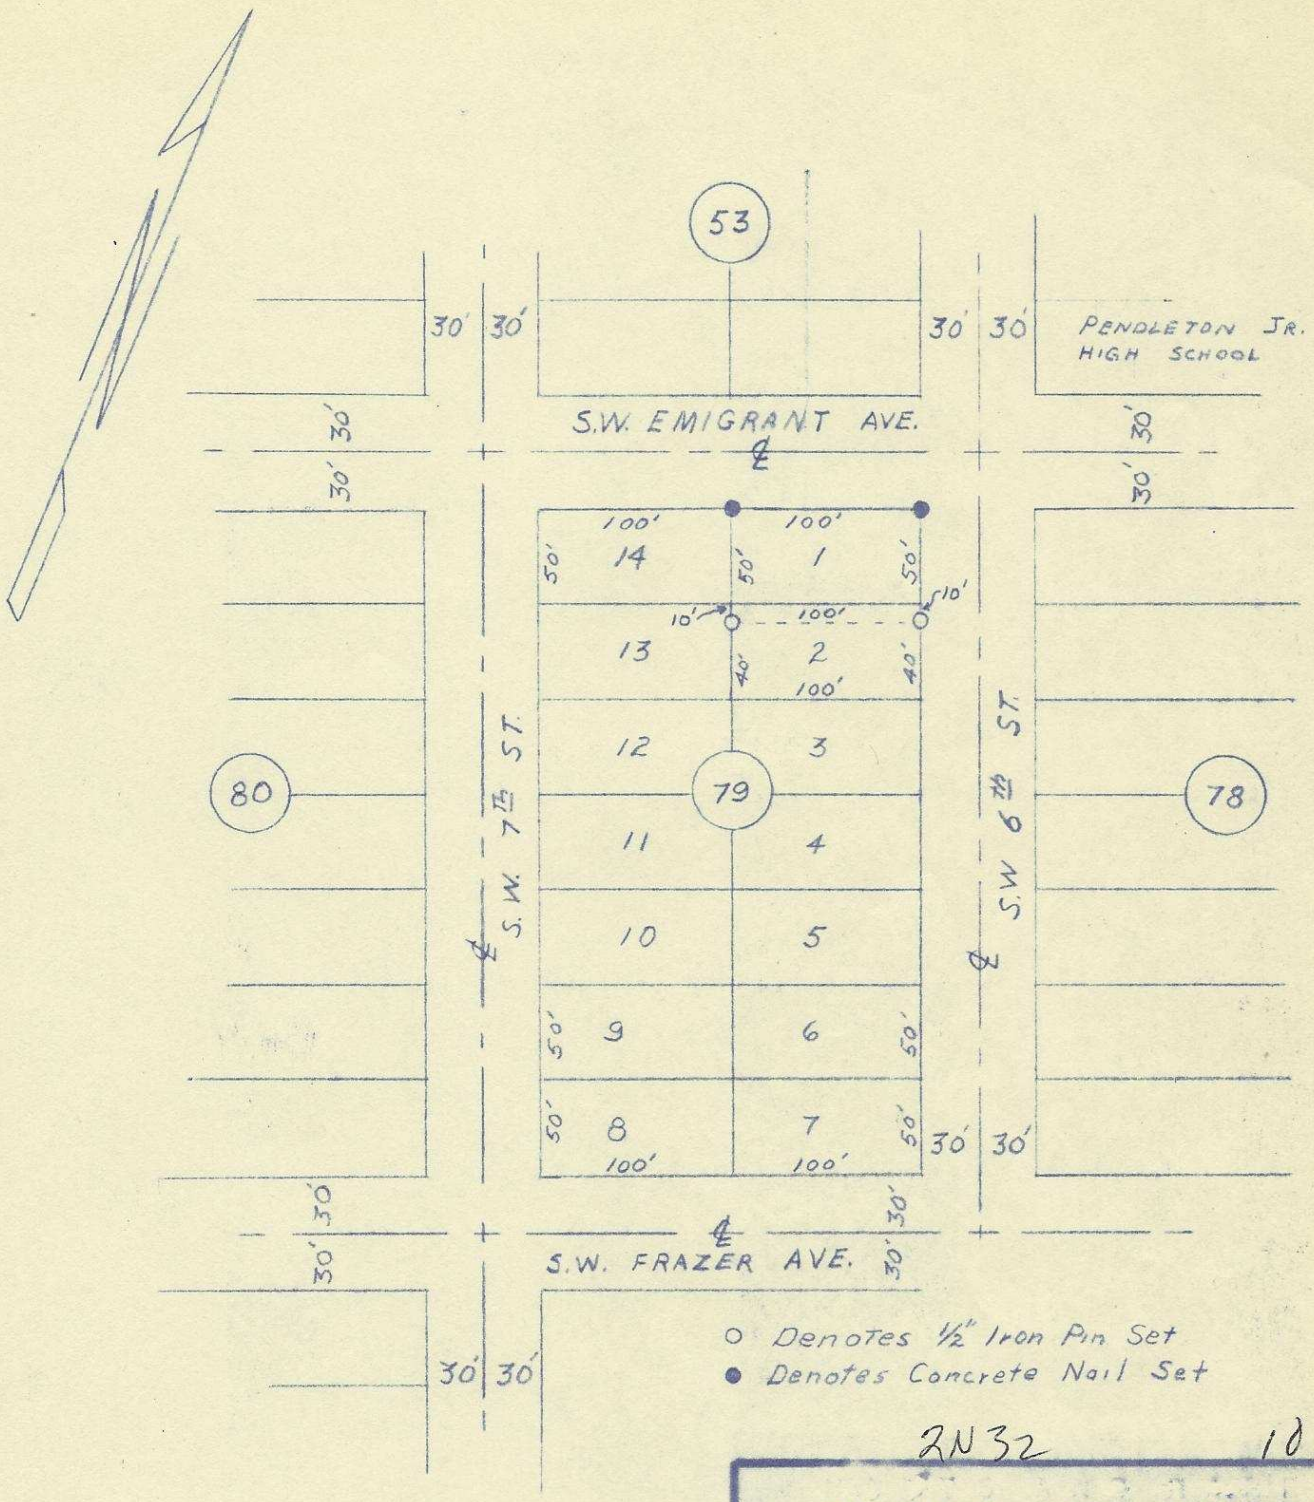

2N32 10AD

HAYES AND HARRIS

SURVEY FOR
DENNIS HACKLER

LOT 1 & N. 10' LOT 2 BLOCK 79

RESERVATION ADDITION
PENDLETON, OREGON

SCALE	DATE	DRN. BY	DRNG. NO.
1"=100'	9-14-64	JLS	64-200

REGISTERED
OREGON
LAND SURVEYOR

Leland H. Ascher

JULY 10, 1964
LELAND H. ASCHER
635

06-535-Ax