


South $\frac{1}{4}$ corner.

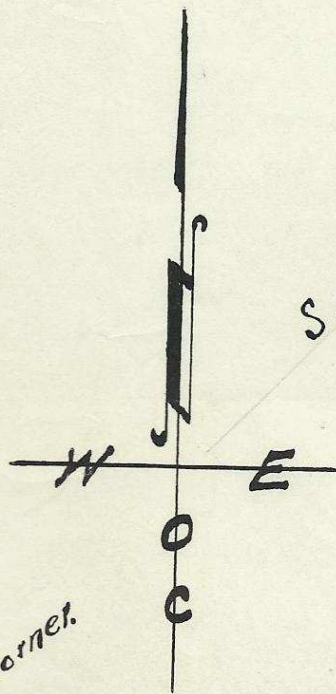

S. W/4 of S.E/4 Sec. 17



Map of
S. W/4 of S.E/4 Sec. 17. T. 1 N., R. 35 E. W. M.
surveyed, staked & platted July-1953.
By W. E. O. Criger - Scale: 1" = 200'

09-152-Ax

Hugh Bowman - Mile 25 $\frac{1}{2}$ W. from Hwy