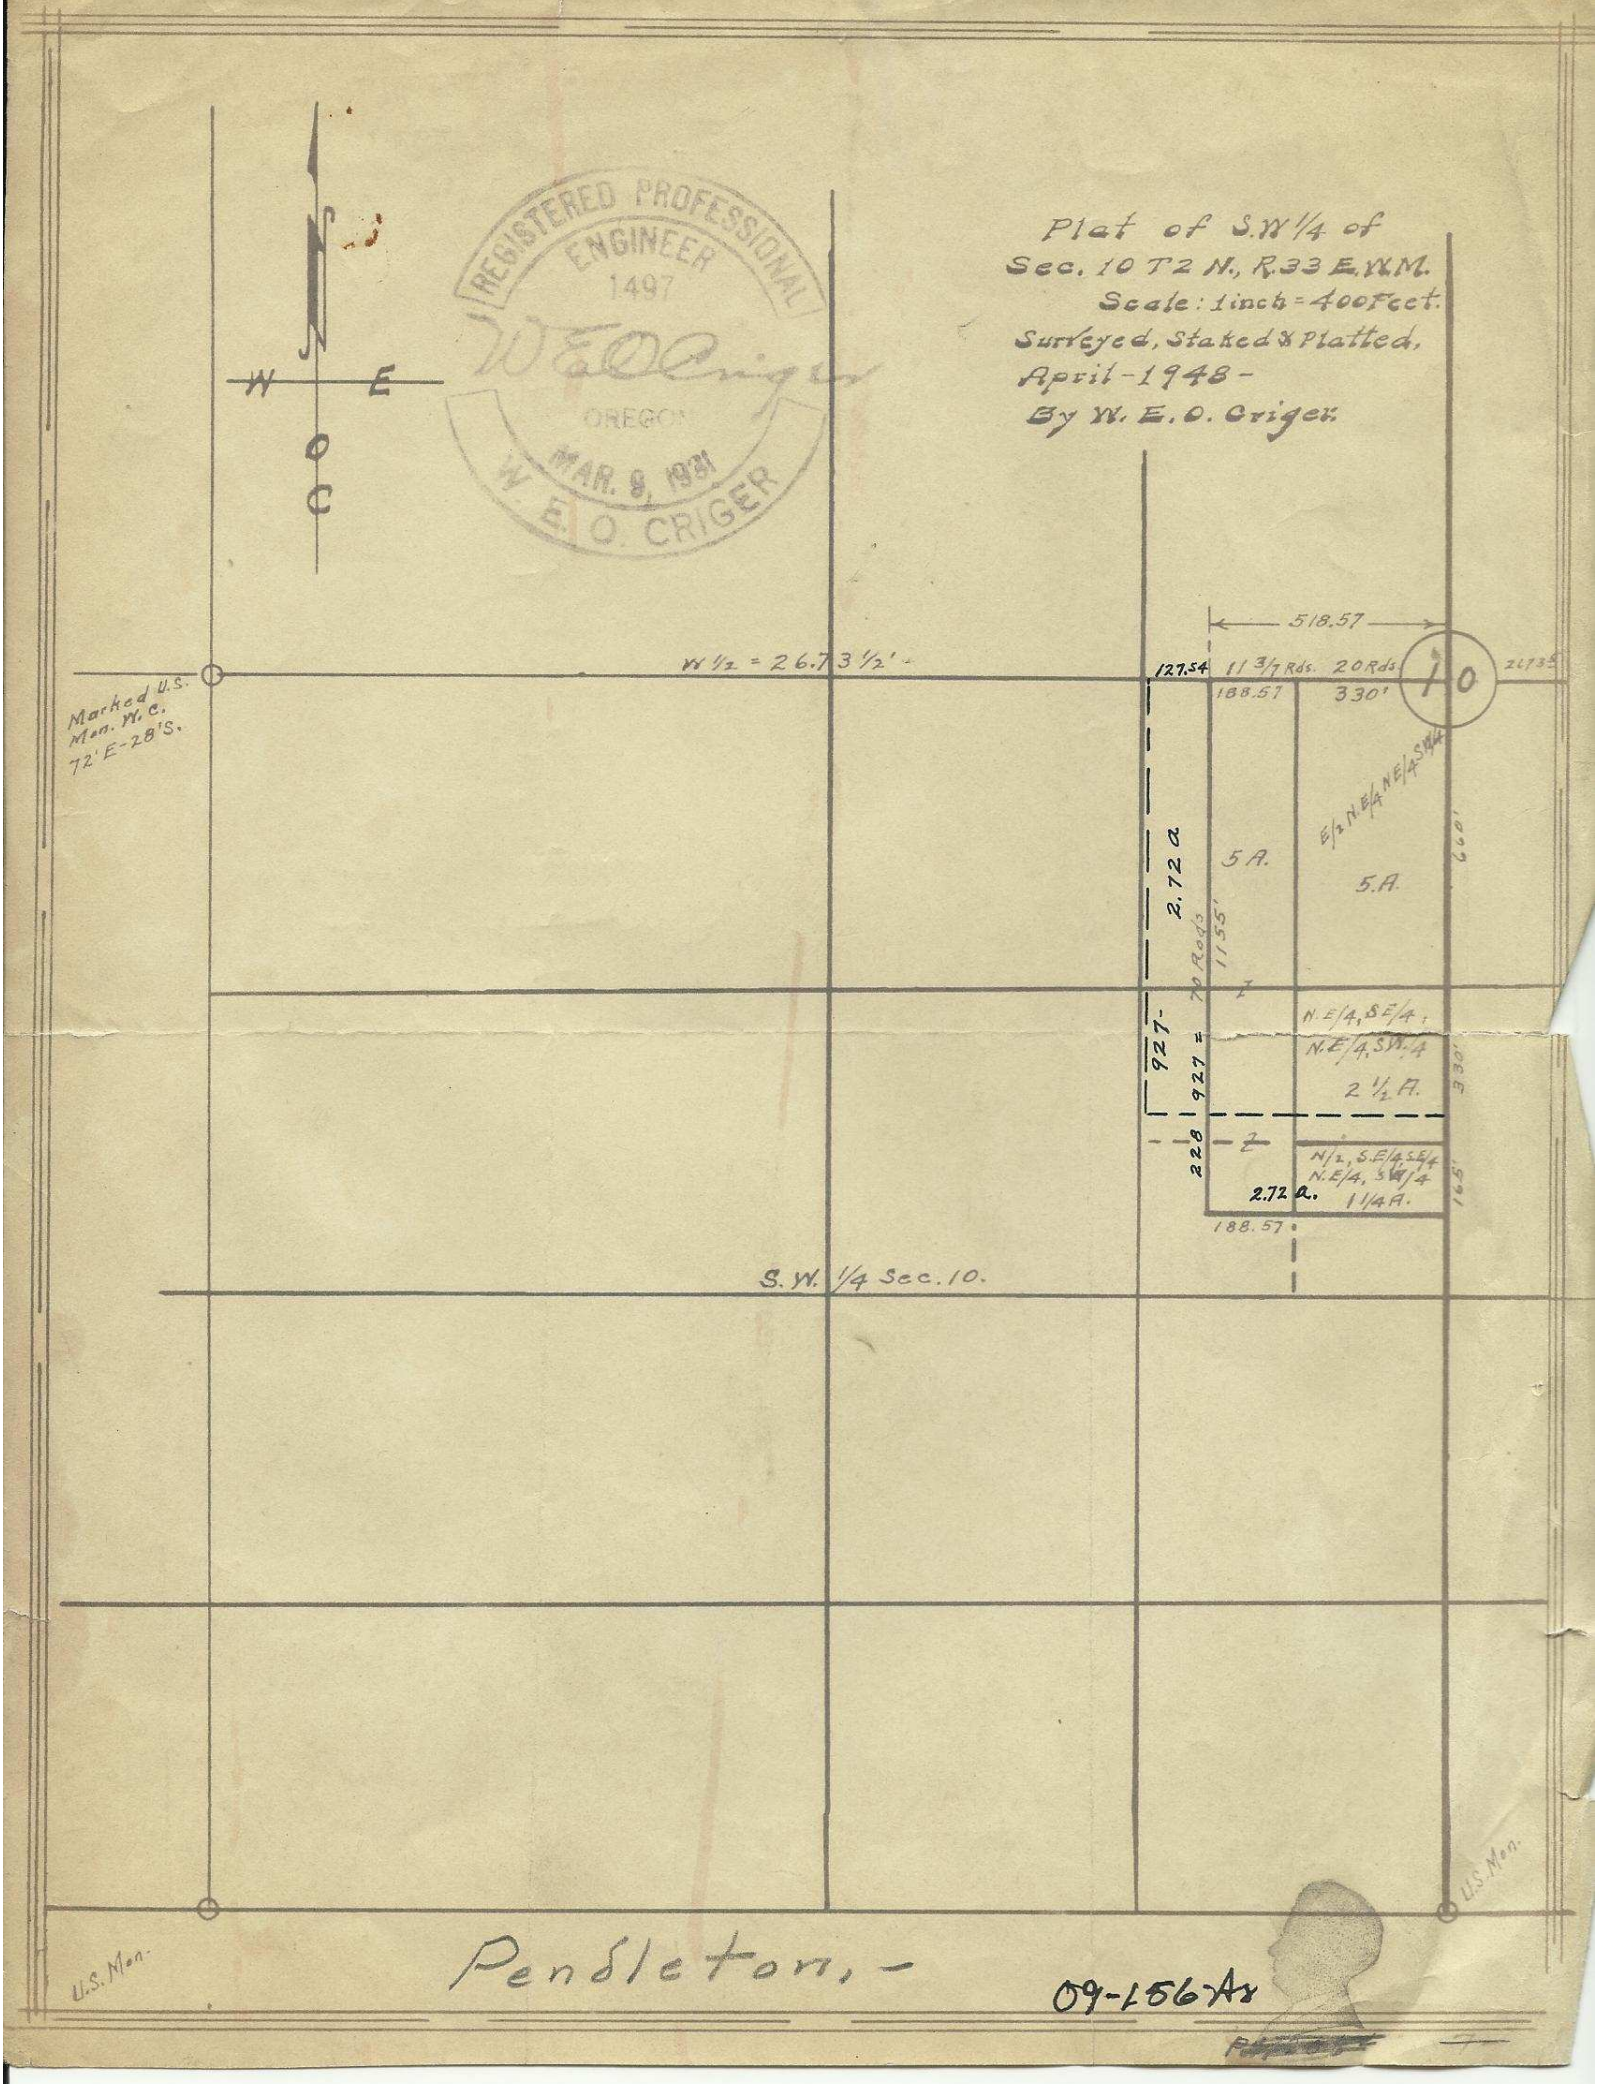
Plat of S.W 1/4 of
Sec. 10 T2 N., R.33 E.W.M.
Scale: 1 inch = 400 Feet.
Surveyed, Staked & Platted,
April - 1948 -
By W. E. O. Criger.
REGISTERED PROFESSIONAL ENGINEER
1497
OREGON
MAR. 9, 1931
W. E. O. CRIGER
W
E
O
C
Marked U.S. Mon. W.C. 72' E - 28' S.
W 1/2 = 26.73 1/2'
518.57
127.54
11 3/7 Rds.
20 Rds.
188.57
330'
10
2673
E/2 N.E/4 N.E/4 S.W/4
5 A.
5 A.
2.72 a
1155'
70 Rods
927
927 =
N.E/4, S.E/4,
N.E/4, S.W/4
2 1/2 A.
330'
228
N/2, S.E/4 S.E/4
N.E/4, S.W/4
2.72 a.
1 1/4 A.
165'
188.57
S.W. 1/4 Sec. 10.
U.S. Mon.
U.S. Mon.
Pendleton, -
09-156 Ar