


WATER ST.

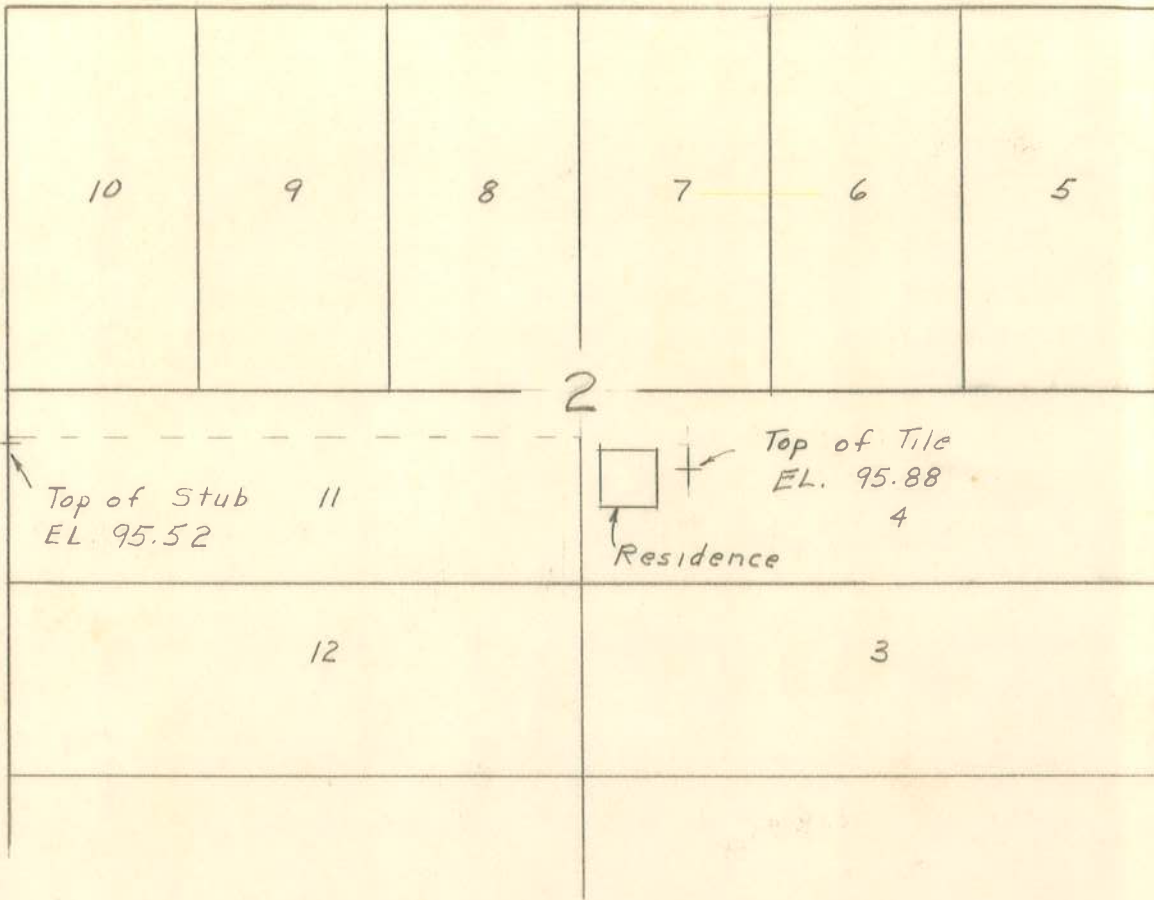

Note: Datum is Assumed

Dist: Lat. to Exposed tile - 141' 7"

Lat. to Proposed
Service 123' 7"

REGISTERED
OREGON
LAND SURVEYOR

Wayne O. Harris

MAY 6, 1953
WAYNE O. HARRIS
346

14-055-Ax

HAYES AND HARRIS

SITE DRAWING

BLOCK
WESTON,

2
OREGON

SCALE	DATE	DRN. BY	DRNG. NO
1"=40'	12-11-64	WOH	65-206