


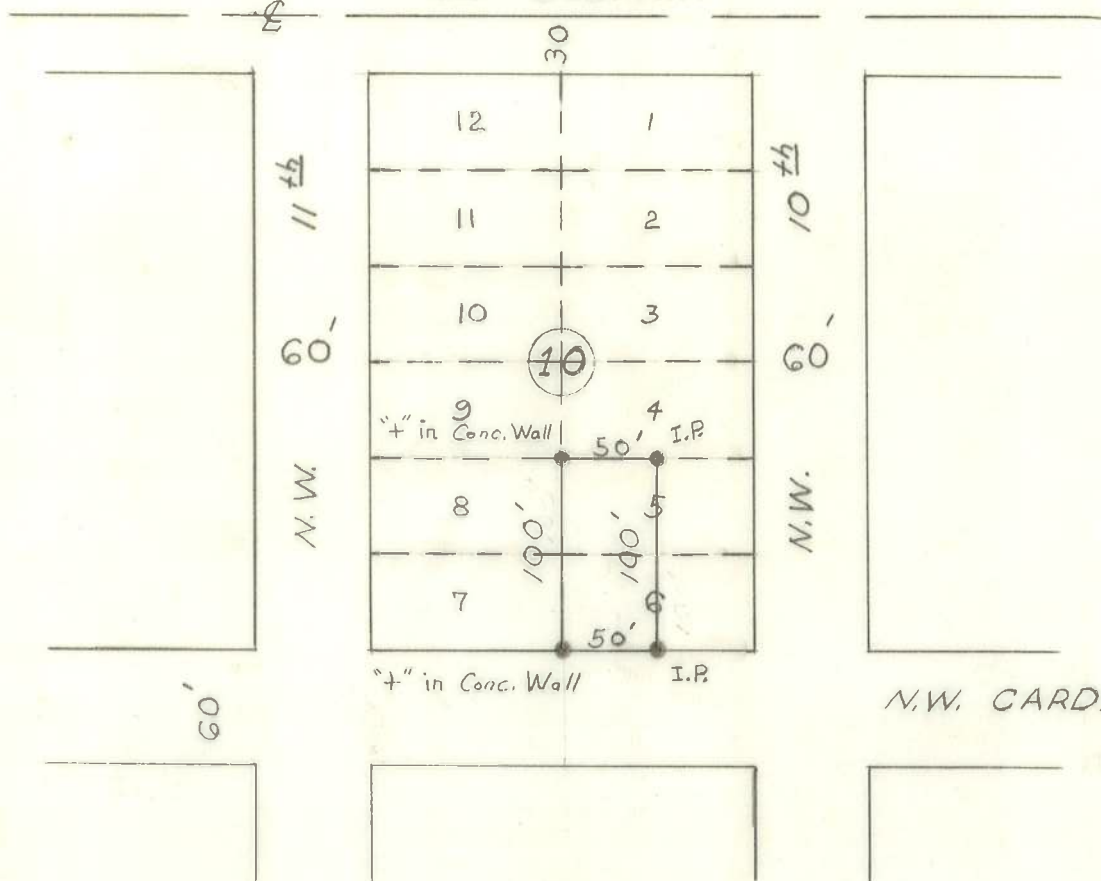

N.W. DESPAIN



N.W. GARDEN

REGISTERED  
**OREGON**  
 LAND SURVEYOR

*Wayne O. Harris*  
 MAY 6, 1955  
**WAYNE O. HARRIS**  
 346

14-073-Ax

HAYES AND HARRIS

WEST HALFS OF LOTS 6 AND 5

HOUSER'S ADDITION

PENDLETON, OREGON

SCALE	DATE	DRN. BY	DRNG. NO.
1" TO 100'	3-28-63	WOH	63-177