


RECEIVED BY
 Umatilla County Surveyor
 Date: 7/25/18
 Recd By: OT
 No.: 18-066-AX

Scale: 1" = 200'

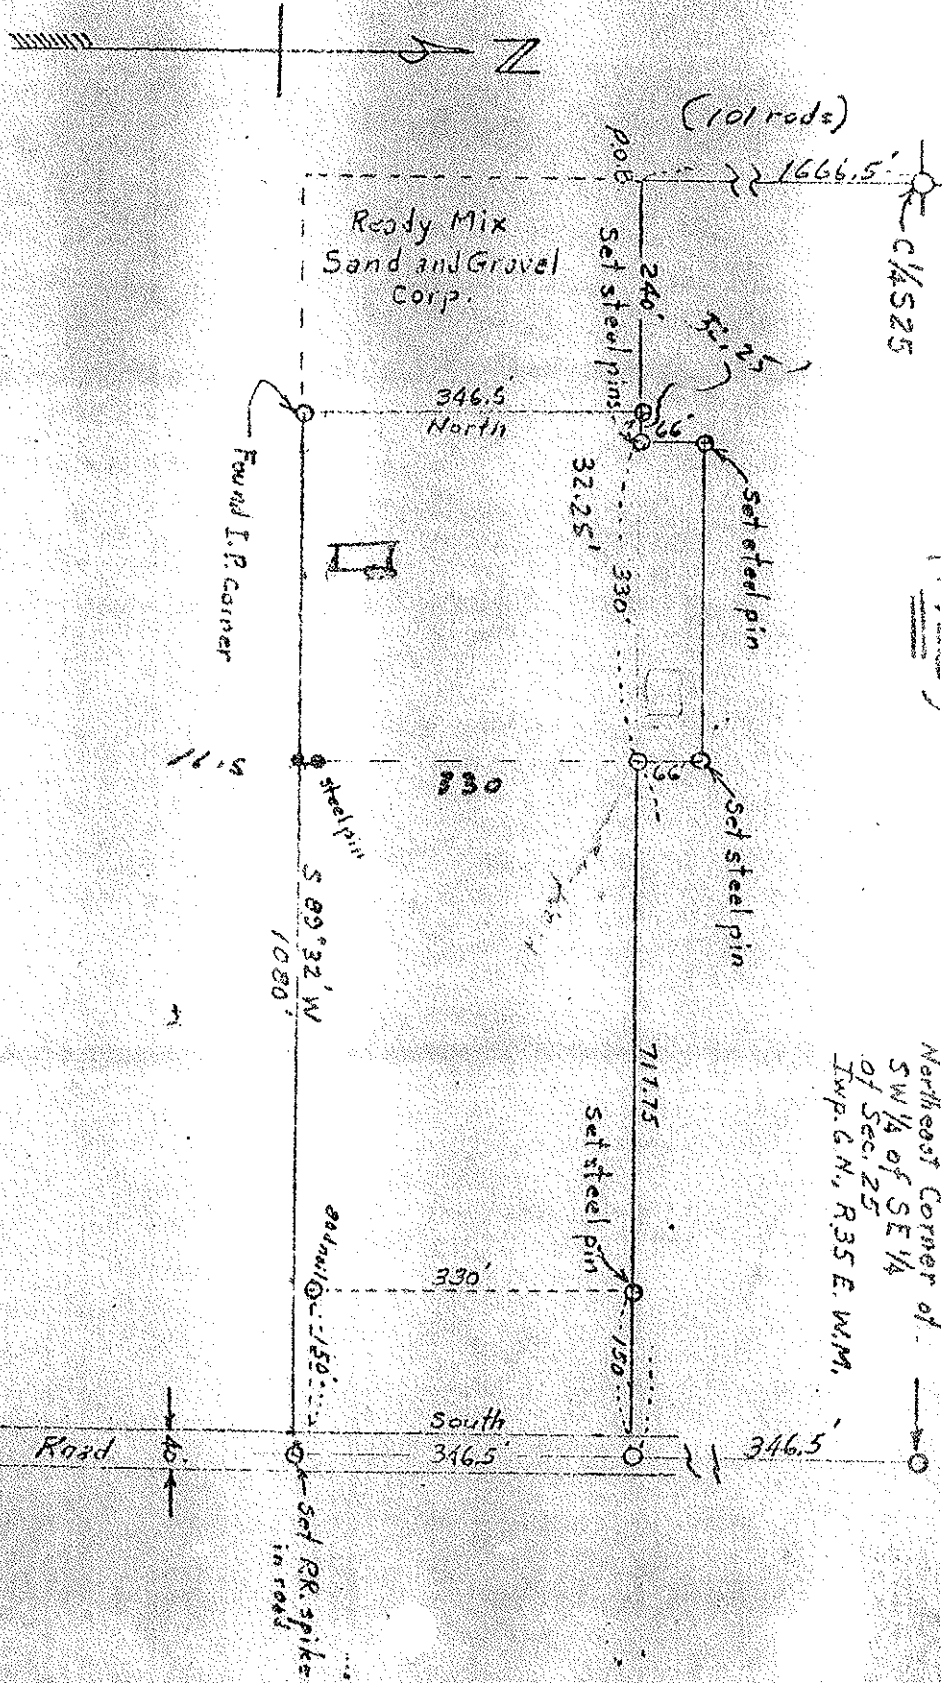

REGISTERED
 O. J. LOMASSON
 LAND SURVEYOR
 OCTOBER 4, 1937
 A. J. LOMASSON
 423

1969

ALLEN J. LOMASSON
 Registered Surveyor
 142 THORNE
 WALLA WALLA, WASHINGTON
 Survey for
 James Corwin
 P.O. Box 131
 Milson - Freewater, Ore.
 30 Aug. 1969