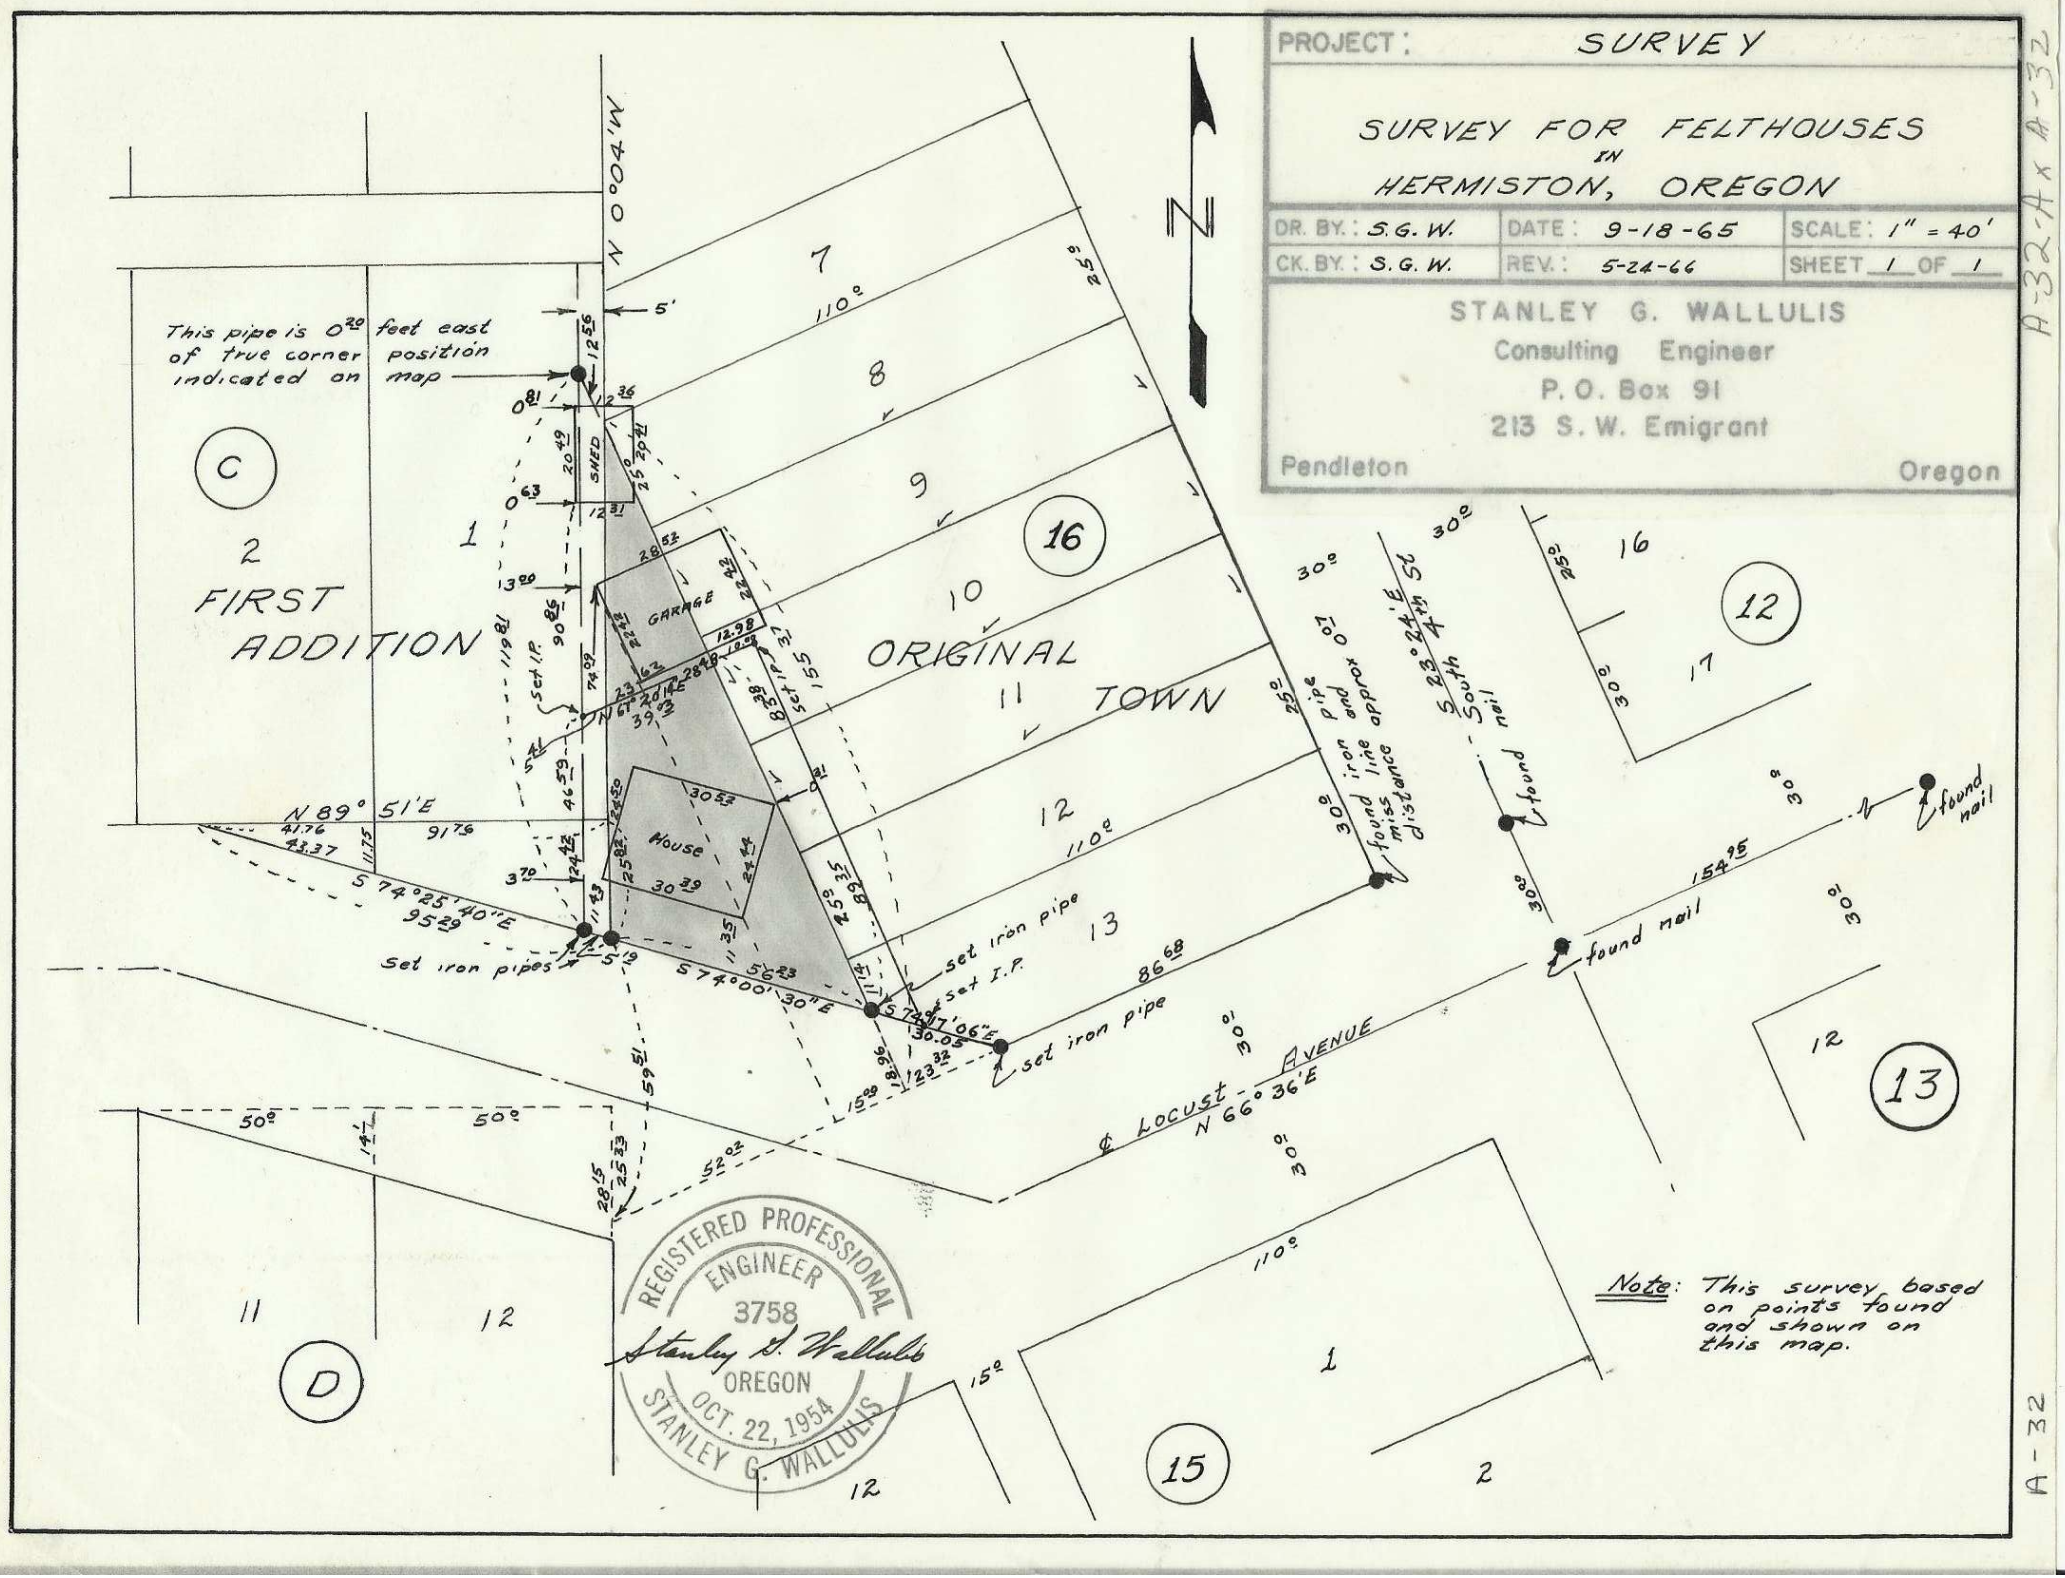
PROJECT: SURVEY
SURVEY FOR FELTHOUSES
IN
HERMISTON, OREGON
DR. BY.: S.G.W.
DATE: 9-18-65
SCALE: 1" = 40'
CK. BY.: S.G.W.
REV.: 5-24-66
SHEET 1 OF 1
STANLEY G. WALLULIS
Consulting Engineer
P. O. Box 91
213 S. W. Emigrant
Pendleton
Oregon
A-32-A x A-32
A-32
N
N 0° 04' W
This pipe is 0.29 feet east of true corner position indicated on map
C
2
FIRST ADDITION
1
7
8
9
10
11
16
ORIGINAL TOWN
12
13
SHED
GARAGE
House
Set I.P.
N 89° 51' E
91.76
S 74° 25' 40" E
95.29
Set iron pipes
S 74° 00' 30" E
56.23
set iron pipe
S 74° 17' 06" E
30.05
set iron pipe
86.68
found iron pipe approx distance
found nail
S 23° 24' E
South 154.75
found nail
found nail
¢ LOCUST AVENUE
N 66° 36' E
D
11
12
15
1
2
Note: This survey based on points found and shown on this map.
REGISTERED PROFESSIONAL ENGINEER
3758
Stanley G. Wallulis
OREGON
OCT. 22, 1954
STANLEY G. WALLULIS