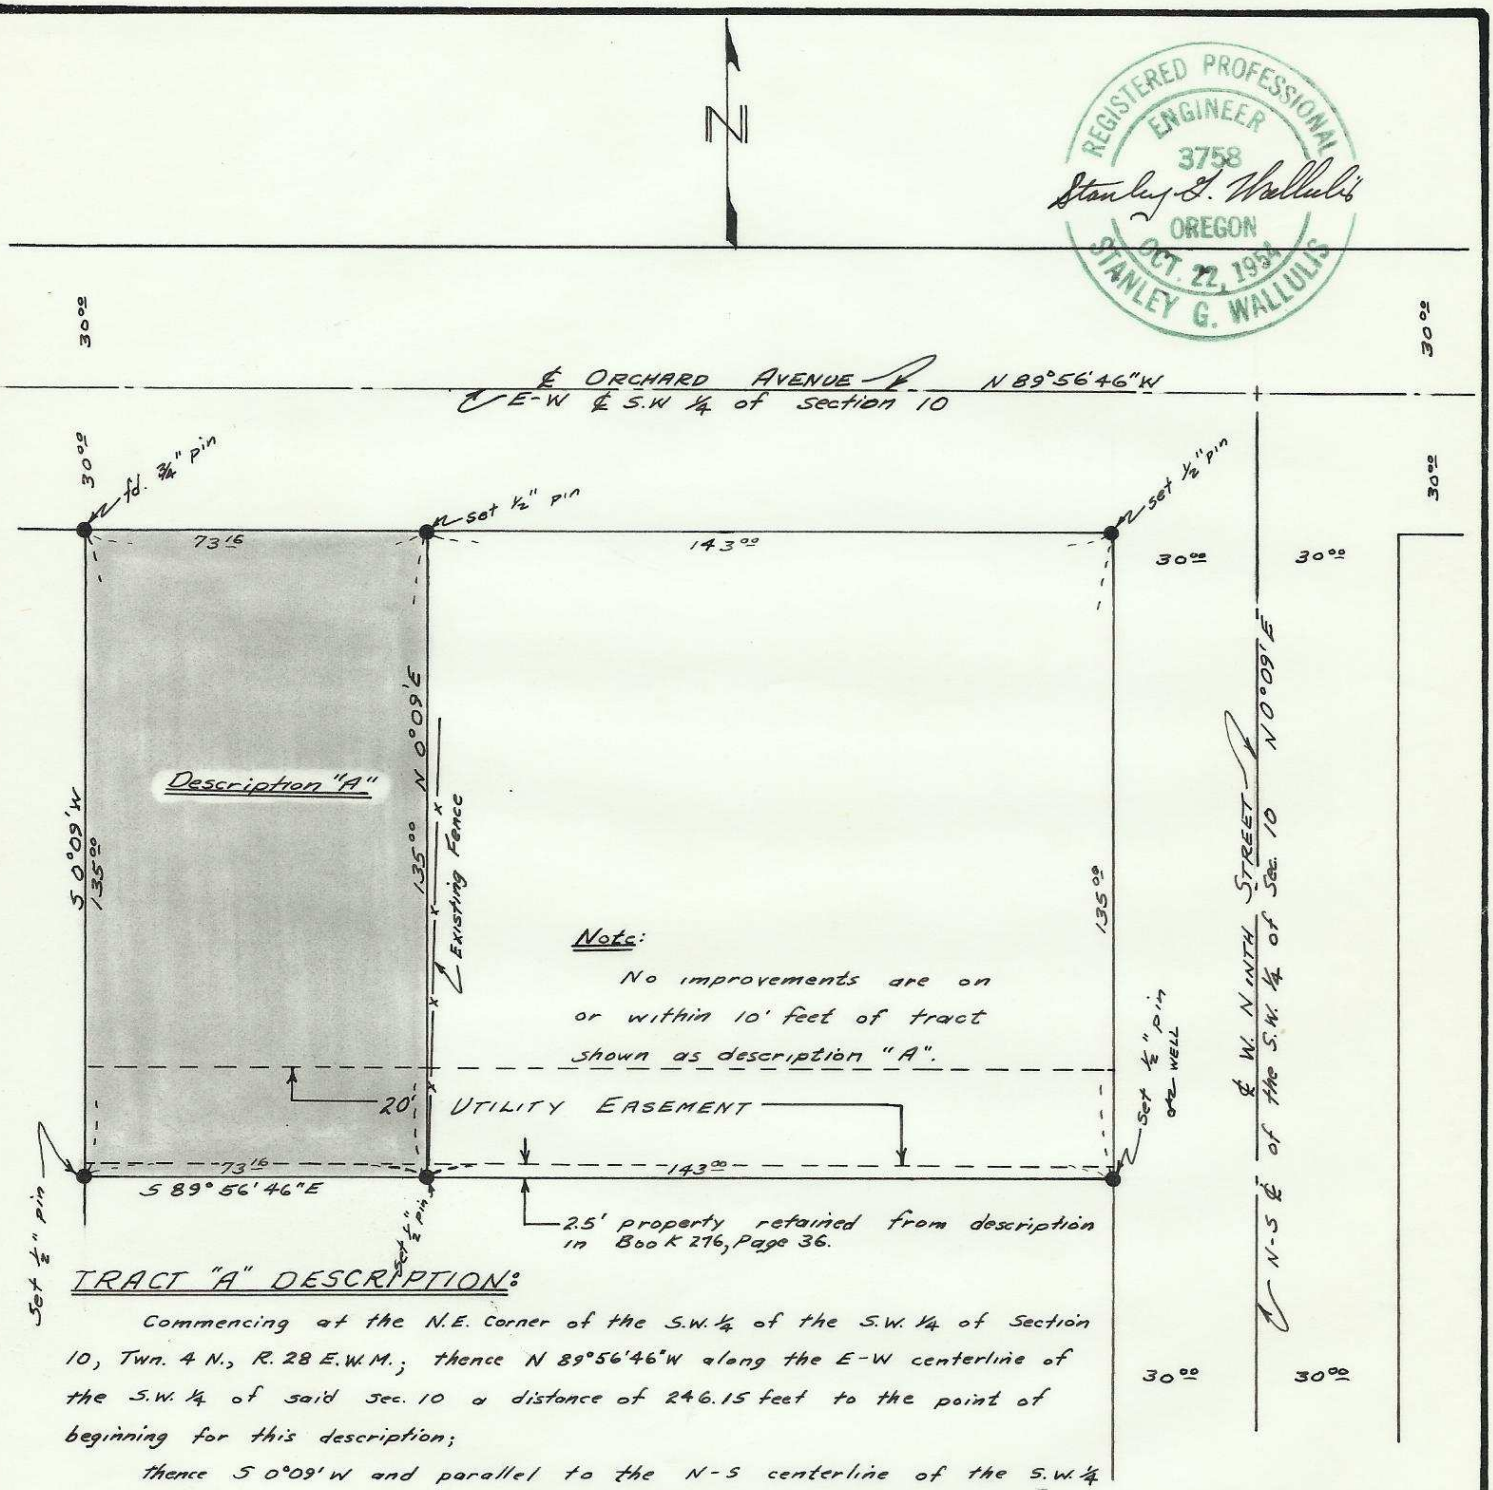

TRACT "A" DESCRIPTION:

Commencing at the N.E. Corner of the S.W. ¼ of the S.W. ¼ of Section 10, Twn. 4 N., R. 28 E.W.M.; thence N 89°56'46"W along the E-W centerline of the S.W. ¼ of said Sec. 10 a distance of 246.15 feet to the point of beginning for this description;

thence S 0°09'W and parallel to the N-S centerline of the S.W. ¼ a distance of 165.00 feet; thence S 89°56'46"E a distance of 73.15 feet; thence N 0°09'E a distance of 165.00 feet to a point on the said E-W centerline; thence N 89°56'46"W along said E-W centerline a distance of 73.15 feet to the point of beginning.

Excepting the Northerly 30.00 feet, water rights of way, and easements of record.

FOR RELEASE FROM STATE LOAN:

Substitute 162.50 for 165.00 underlined in above description.

SURVEY FOR
RUSS PIERSOL
In the S.W ¼ of S.W ¼, Sec. 10, Twn 4 N, R. 28 E.

Scale 1" = 40'	Date: 5-21-66	By: S.G.W.

WALLULIS & STAEBLER
Consulting Engineers
P.O. Box 91
Pendleton Oregon

A-53

A-53-A x A 53