


H-39-Ax

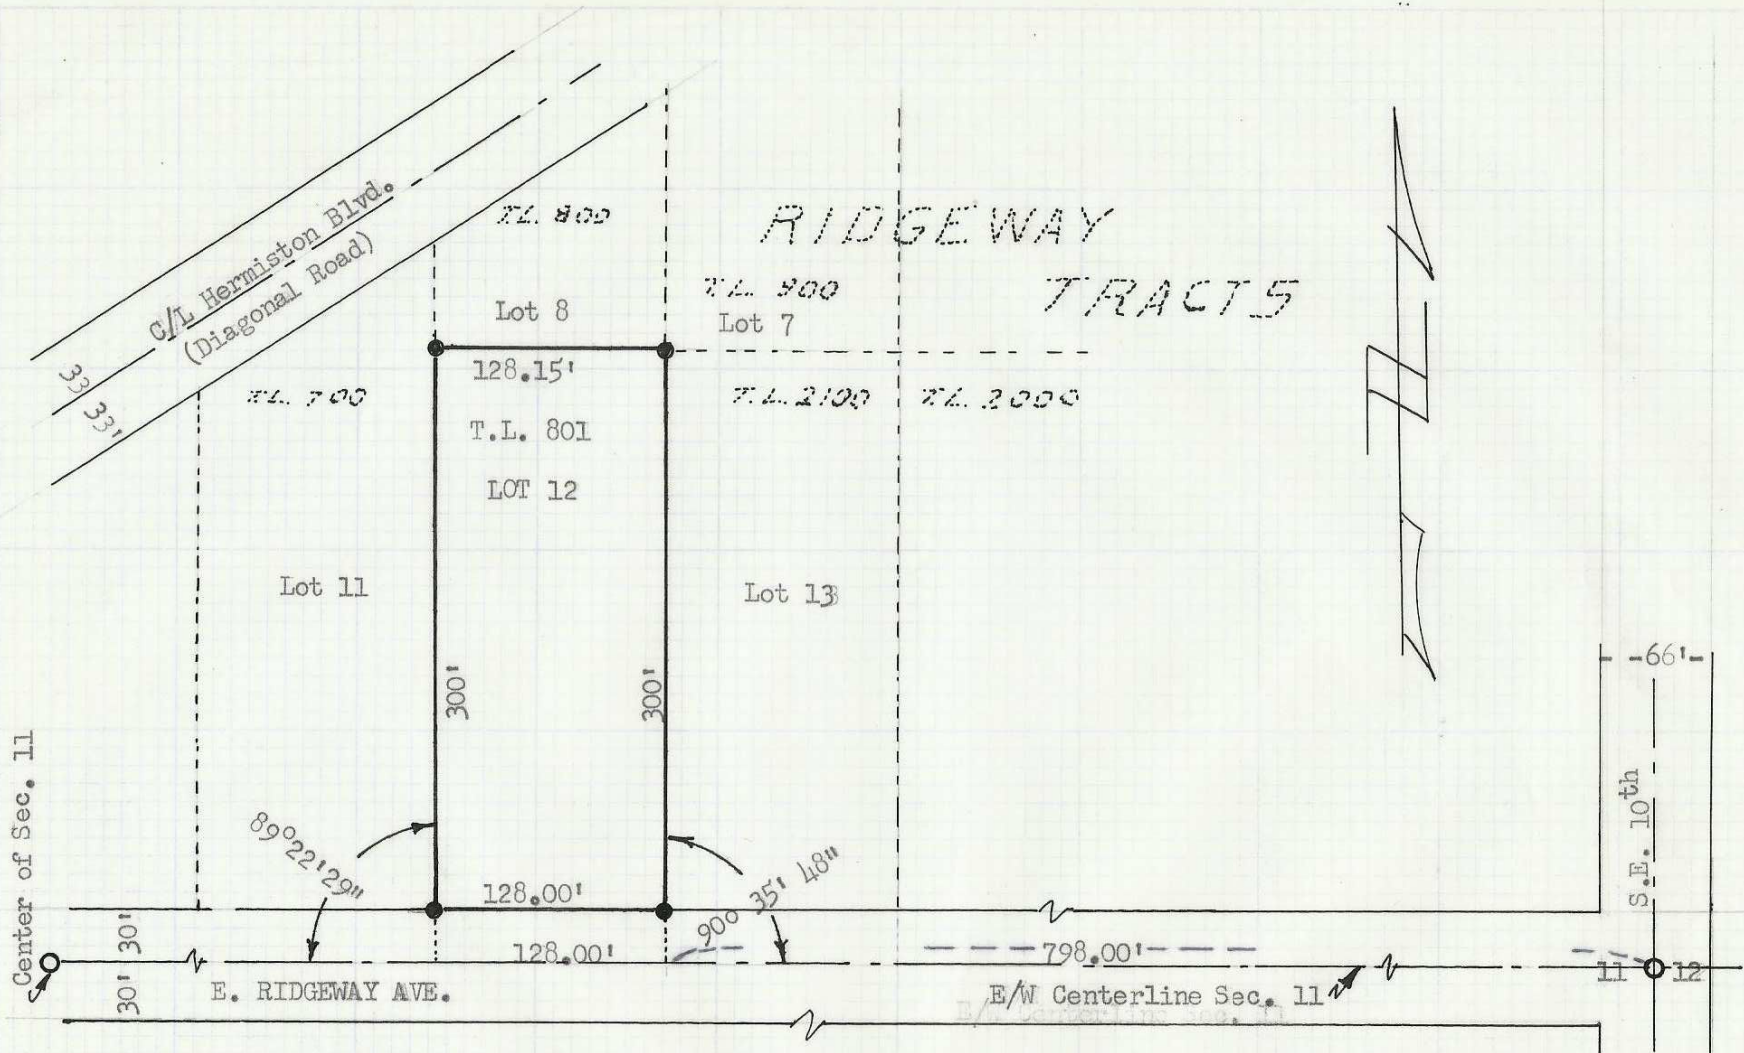

Center of Sec. 11

C/L Hermiston Blvd.
(Diagonal Road)

RIDGEWAY TRACTS 5

LEGEND

- Fnd. Iron Pipe
- Set Iron Pin

REGISTERED
OREGON
LAND SURVEYOR

Ralph P. Thompson

MAY 13, 1960
RALPH P. THOMPSON
506

SURVEY FOR
BERTIE IRENE QUAYLE
Lot 12, RIDGEWAY TRACTS,
HERMISTON, OREGON
N.E. 1/4, Sec. 11, T. 4N. R. 28 EWM

Scale: 1"=100' Date: 10/21/71

RALPH THOMPSON
REGISTERED LAND SURVEYOR
P.O. BOX 1082, PENDLETON, ORE. 97901

H-39