
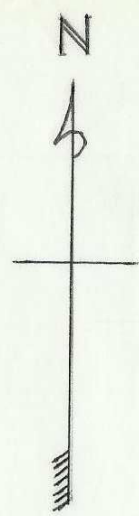


Sec. 24, T.6N., R.35E.

H-102-A

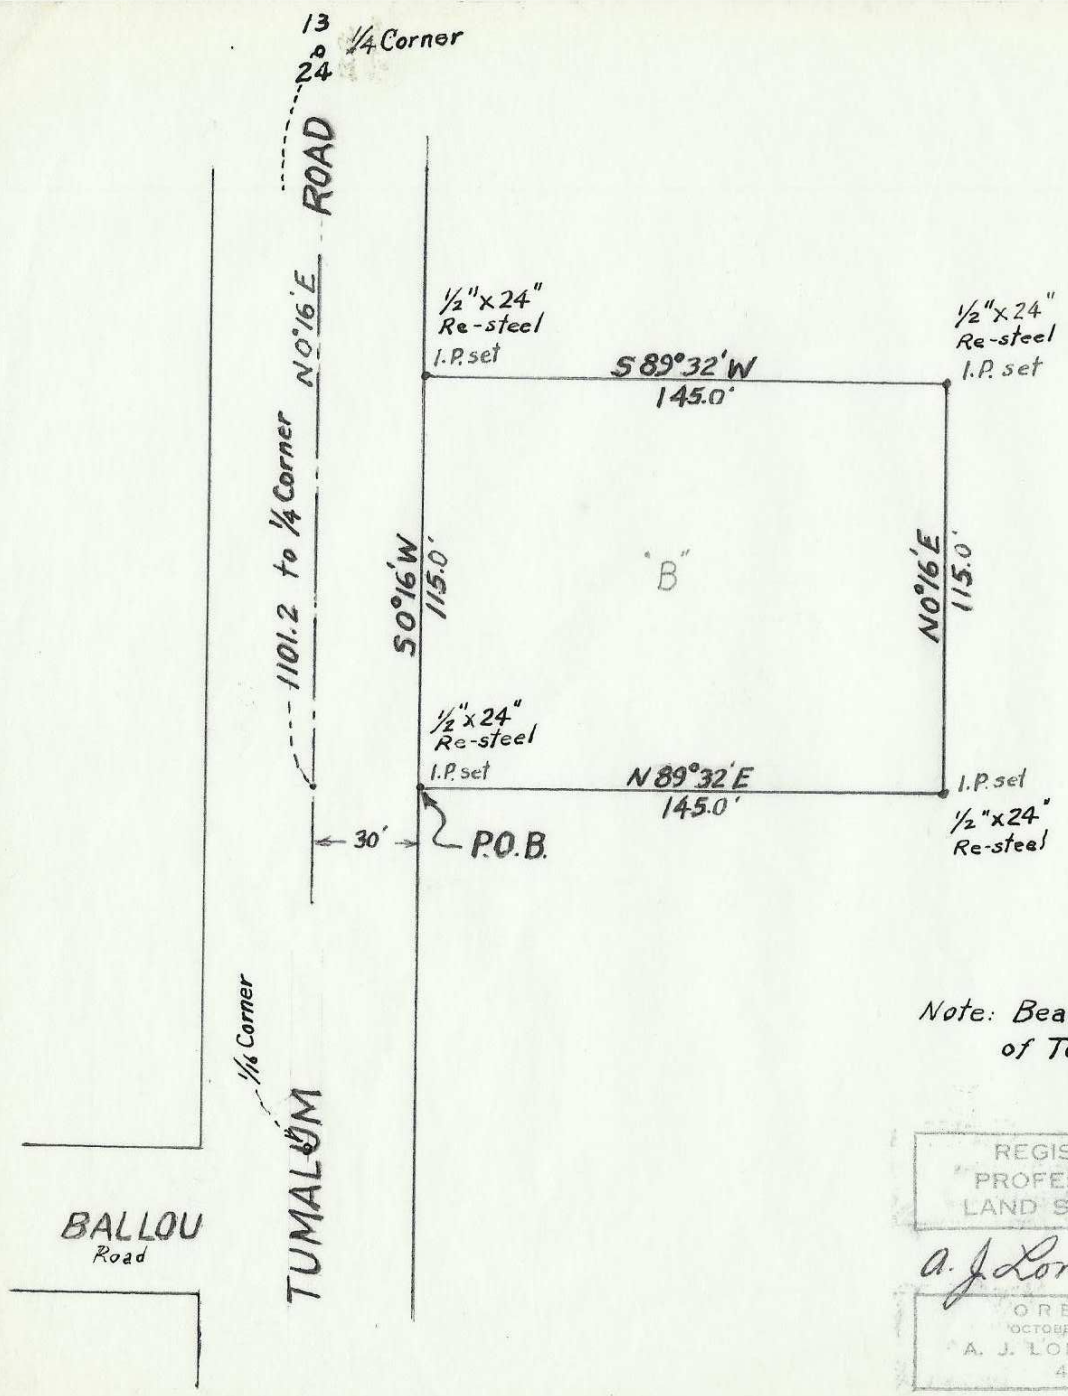

Scale: 1" = 50'

Note: Bearings shown are based on centerline of Tumalum Road which is N0°16'E.

REGISTERED
PROFESSIONAL
LAND SURVEYOR

A. J. Lommasson

OREGON
OCTOBER 4, 1997
A. J. LOMMASSON
422

ALLEN J. LOMMASSON
Registered Surveyor
142 THORNE
WALLA WALLA, WASHINGTON

Survey for
JOHN R. STARLIN
4/8/12

H-102