


Found RR spike at First Street

STATE

60' SE 2ND

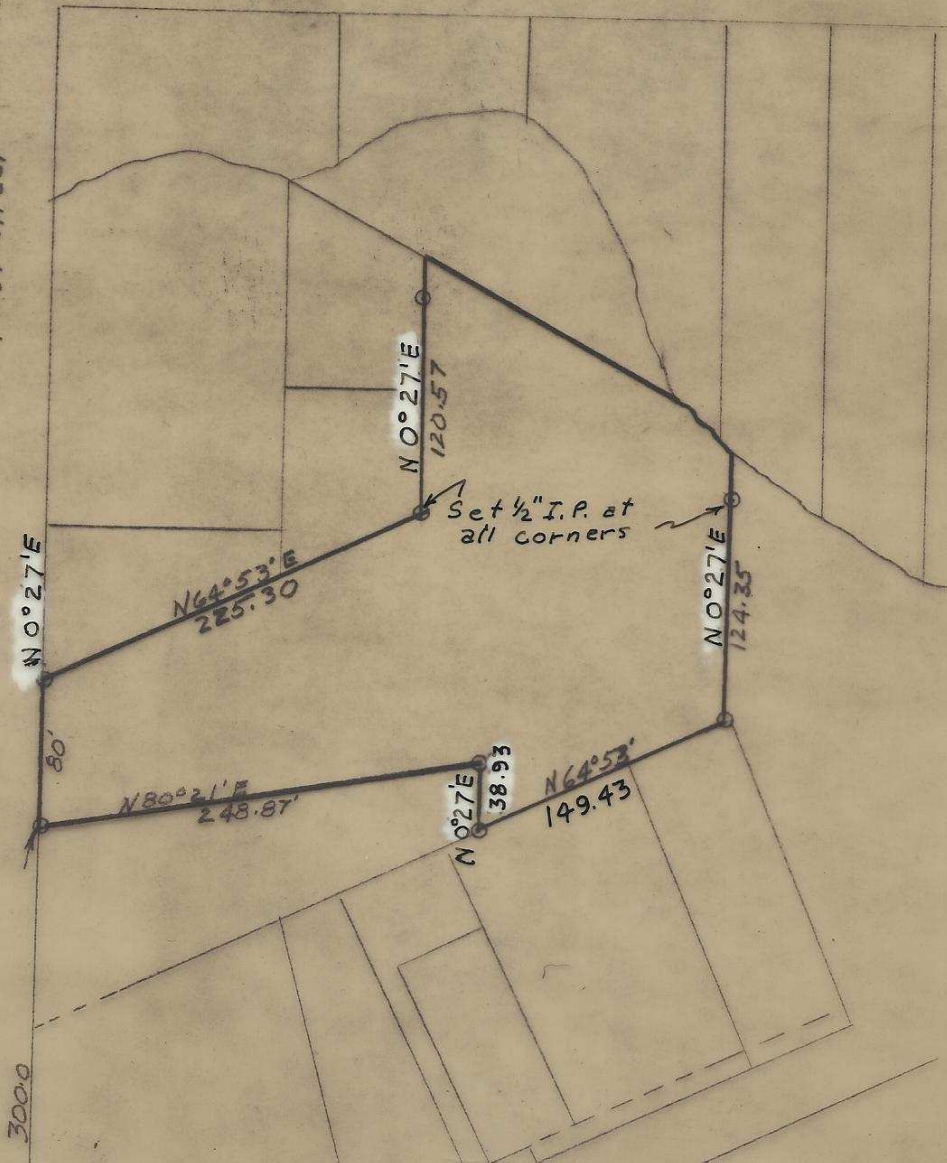

Bearings based on legal description and Auditor's map.

NW cor. NE 1/4 NW 1/4
Nail Found

Set Nail
64°53'

Mon. Found

SE 3RD

MILTON STREET



SURVEY FOR
CHARLES NELSON

MILTON-FREEWATER, OREGON
Scale 1" = 100' Feb. 19, 1973

SWY-1-SN 35E