


I-70-Ax

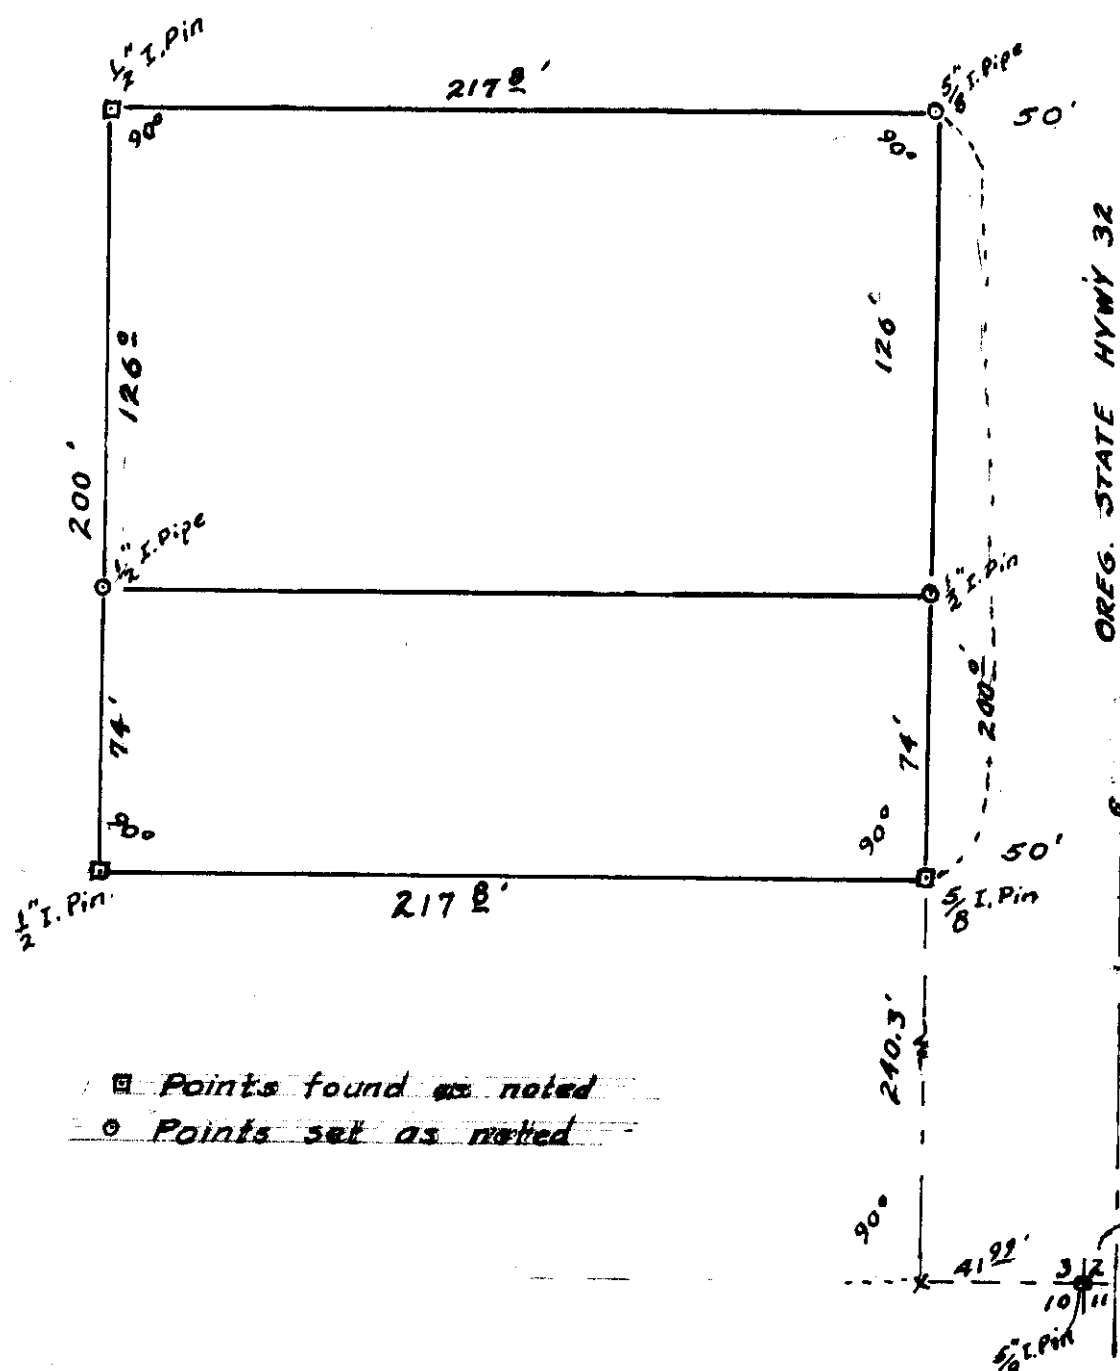

- Points found as noted
- Points set as noted



I-70

For Western Steel Co.
 PLAT OF LOT SURVEY
 IN SW 1/4 SEC. 3 T4N, R28E W.M.
 UMATILLA COUNTY OREGON
 SCALE 1" = 50' 4/13/74

4N-28-03D