


Found nail  
15.7' N. of  
1/4 corner

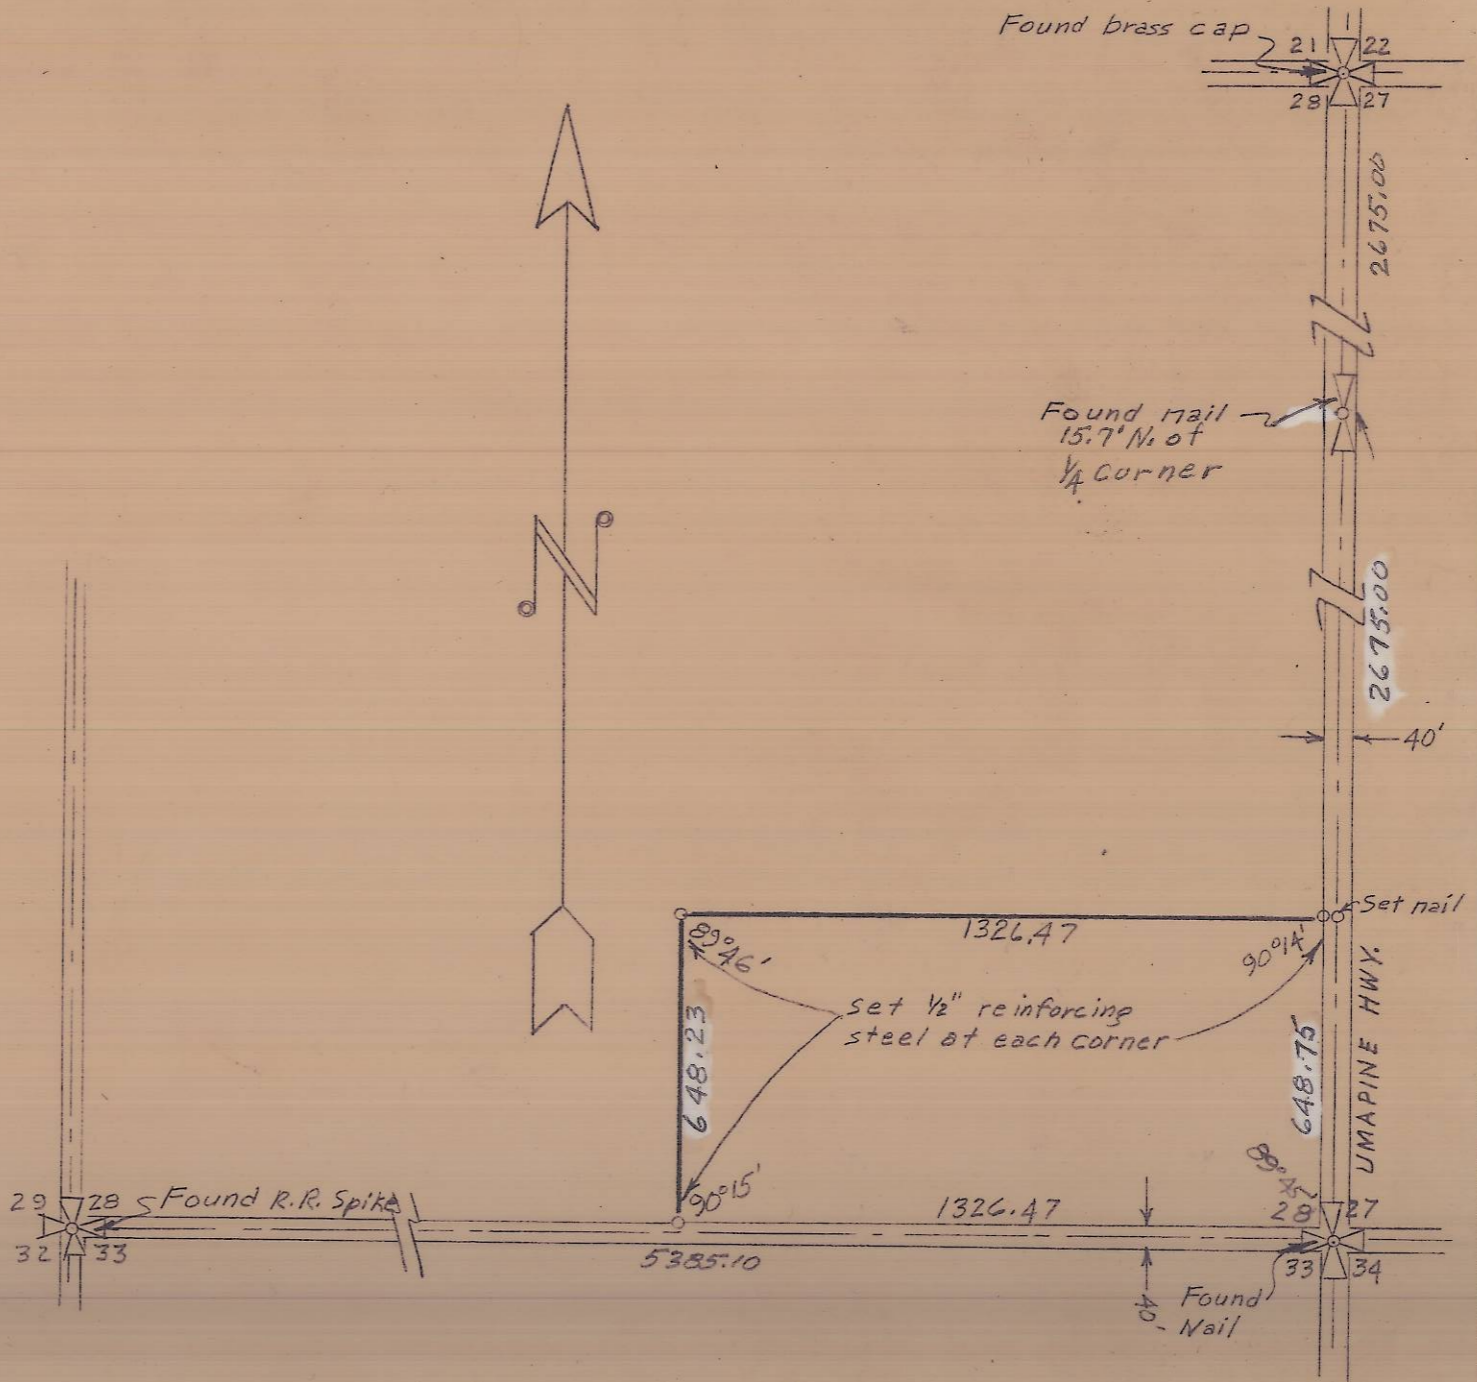

SURVEY FOR  
**ELMER ROLOFF**  
S 1/4 SE 1/4 SEC. 28 T. 6N. R. 35E W.M.  
Scale 1" = 400'  
June 1, 1974



I-91  
Survey 732