


SURVEY FOR  
**REUBEN HEADLEY**  
**BERNARD DUFFY**  
 MILTON-FREEWATER, ORE.  
 Scale 1" = 100' Sept. 5, 1973

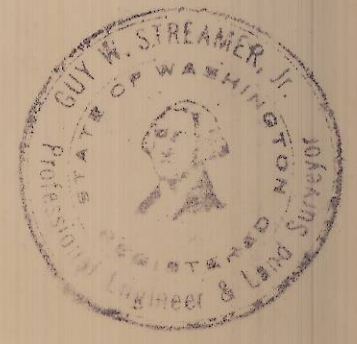

I-100-Ax  
 Survey 6954699