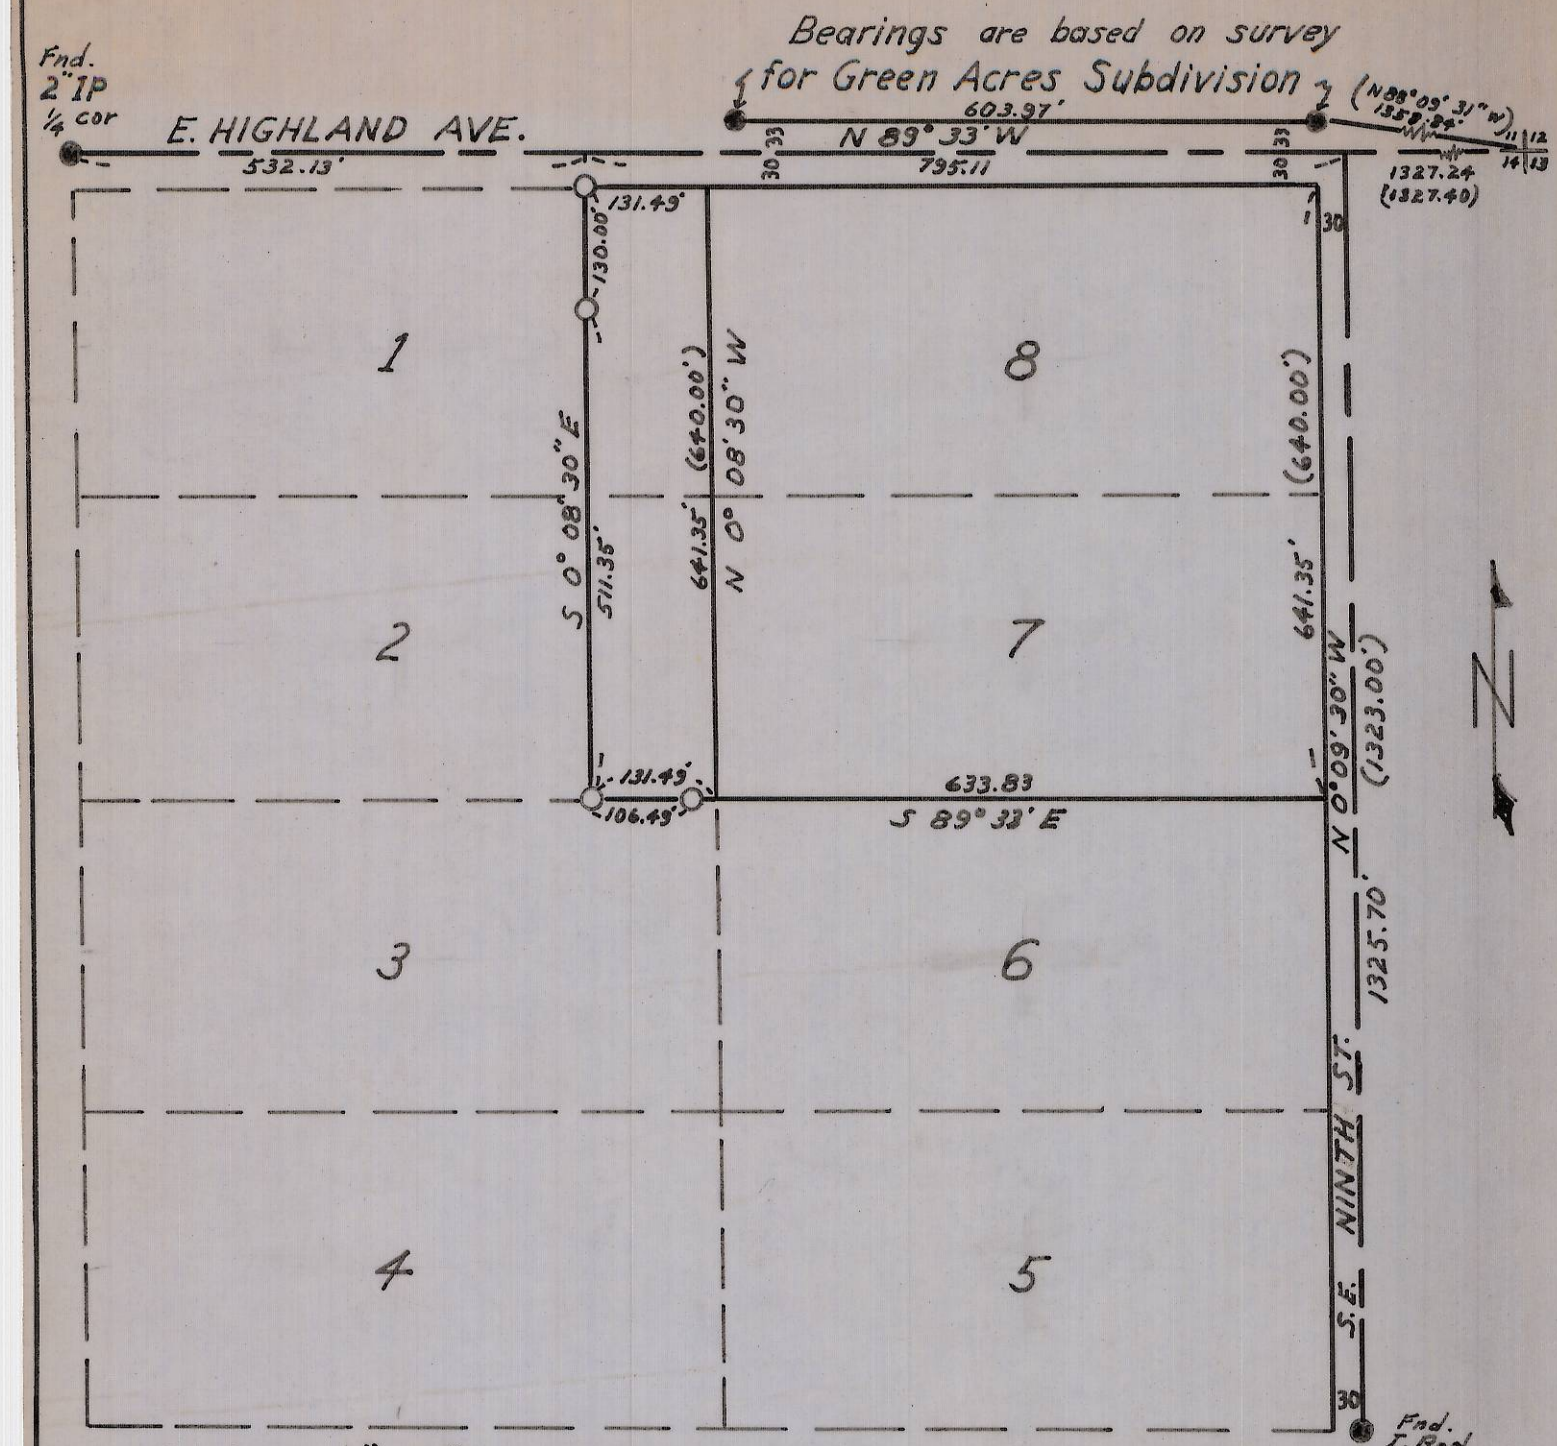

BLOCK "J" HERMISTON ORCHARDS

Scale : 1" = 200'

● Monuments Found

O ½" Iron Rods Set

(00) Record

REGISTERED
PROFESSIONAL
LAND SURVEYOR

G. Dennis Edwards

OREGON
JULY 16, 1971
G. DENNIS EDWARDS
951

Survey For BRUCE GIDDENS

In the NE ¼ Sec. 14 T. 4 N. R. 28 E. W.M.

Jan. 26, 1975

City of Hermiston, Umatilla County, Oregon

J 75-7

J-7-A