


Site Map
1"=400'

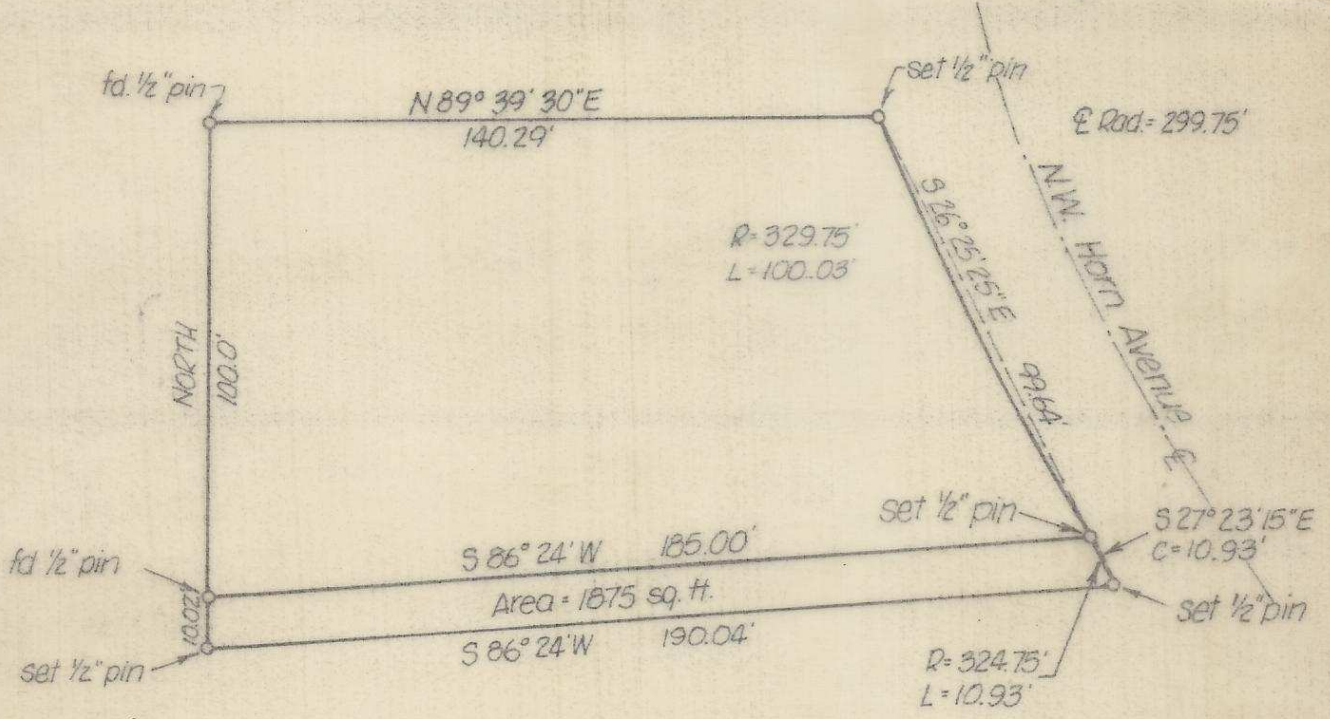

L-30

REGISTERED
PROFESSIONAL
LAND SURVEYOR
David H. Krumbein
OREGON
JULY 17, 1970
DAVID H. KRUMBEIN
933

KRUMBEIN ENGINEERING CO.
ENGINEERS - SURVEYORS - PLANNERS
216 S.E. 1st, Pendleton, Oregon

Survey for Bud Lewis

SCALE 1"=40'
DATE Mar. 30, 1976
DRN. BY P.L.P.
CKD. BY D.H.K.
DRNG. NO. 76-41

L-30-Ax
2N-32-03