


LEGEND
 □ POINTS FOUND
 ○ POINTS SET
 BEARINGS BASED ON 1906 G.L.O. SURVEY
 OF SEC. 32 & LOTTING OF S.W. 1/4 OF SAME

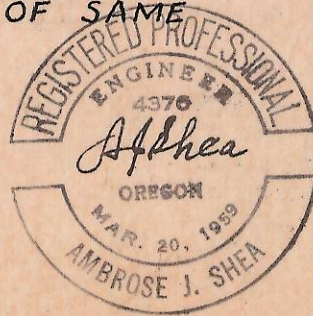

PROPERTY SURVEY PLAT OF
 TRACTS IN SE 1/4 SEC. 31, T5N, R29E, W.M.
 UMATILLA CO. OR.
 FOR FORCADE TO BORKEVIC & LUGAUER
 SCALE 1" = 200'
 8-7-76

L-57

L-51-A