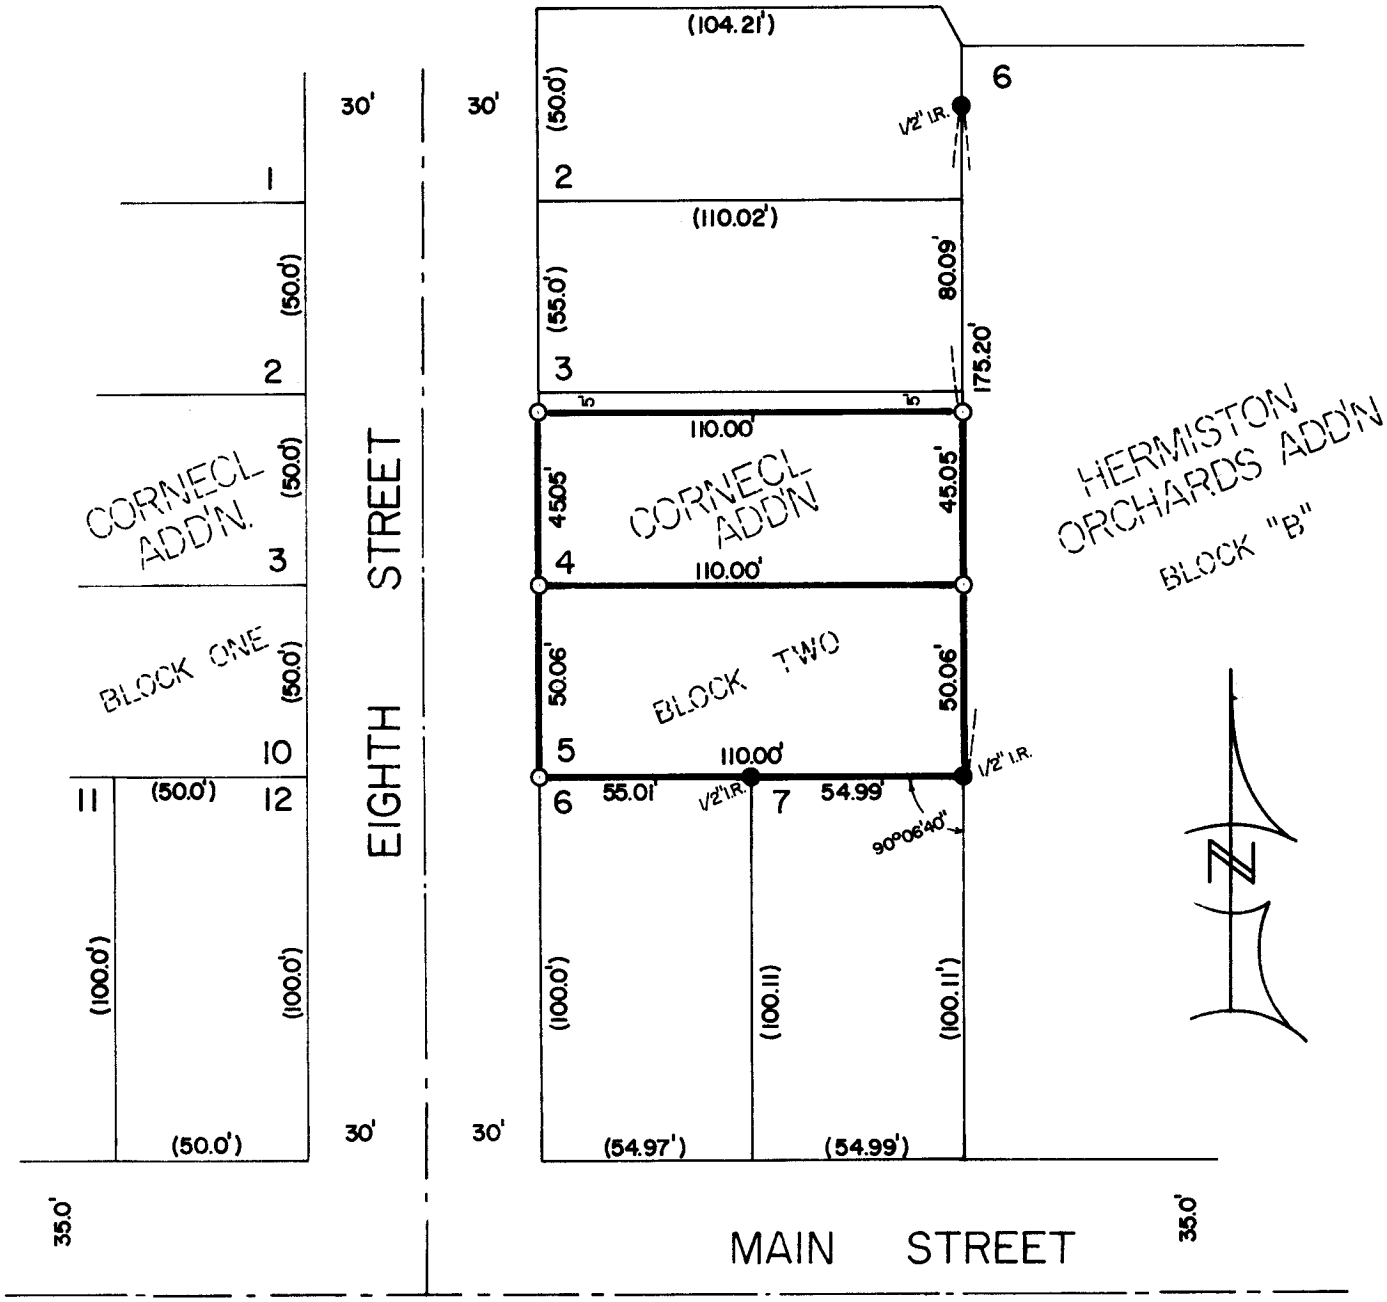

M-021-AY

REGISTERED PROFESSIONAL LAND SURVEYOR

G. Dennis Edwards

OREGON
JULY 16, 1971
G. DENNIS EDWARDS
951

SURVEY FOR T., T., & W. BUILDERS

LOCATION LOTS 4 & 5, BLOCK 2, CORNECL ADDITION TO THE CITY OF HERMISTON, IN THE SE 1/4 OF SEC. 11, T 4 N, R 28 E, W.M., UMATILLA COUNTY, OREGON

DATE: 1-26-77 SCALE: 1" = 50'

● MONUMENTS FOUND (000) OF RECORD

o 1/2" IRON RODS SET JOB NO. S7701012

EDWARDS SURVEYING
567-3336

P. O. Box 763
Hermiston, Ore.