

KEUFEL & ESSER CO. MADE IN U.S.A.

SW. Emigrant Ave.

SW. Isaac Ave.

290.00

(200)

276

275

South Line, Res. Add. To Pendleton, Ore.

R.B.#6


Main St.

6th St.

South

SE.

R.R. Spike

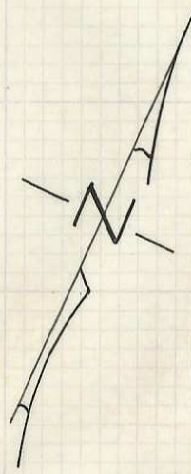

- 5/8" I.P. Set
- 1/2" I.P. Set
- 5/8" I.P. Fnd.
- Other Mon. Fnd.
- City Mon. Fnd.

REGISTERED PROFESSIONAL LAND SURVEYOR

Ralph P. Thompson

OREGON MAY 23, 1960 RALPH P. THOMPSON SCS

Property Survey For CHEROKEE CONST. Lots 1-4 & 13-16 Bk. 275 Res Add. Pendleton, Ore. In SW 1/4 S.E. 1/4 Sec. 10, T. 2 N. R. 32 E. W.M.

Date: 4-14-78 Scale: 1"=100'

RALPH THOMPSON REGISTERED LAND SURVEYOR P. O. BOX 1082 - PENDLETON, ORE. 97801

P-21

P-21-A x