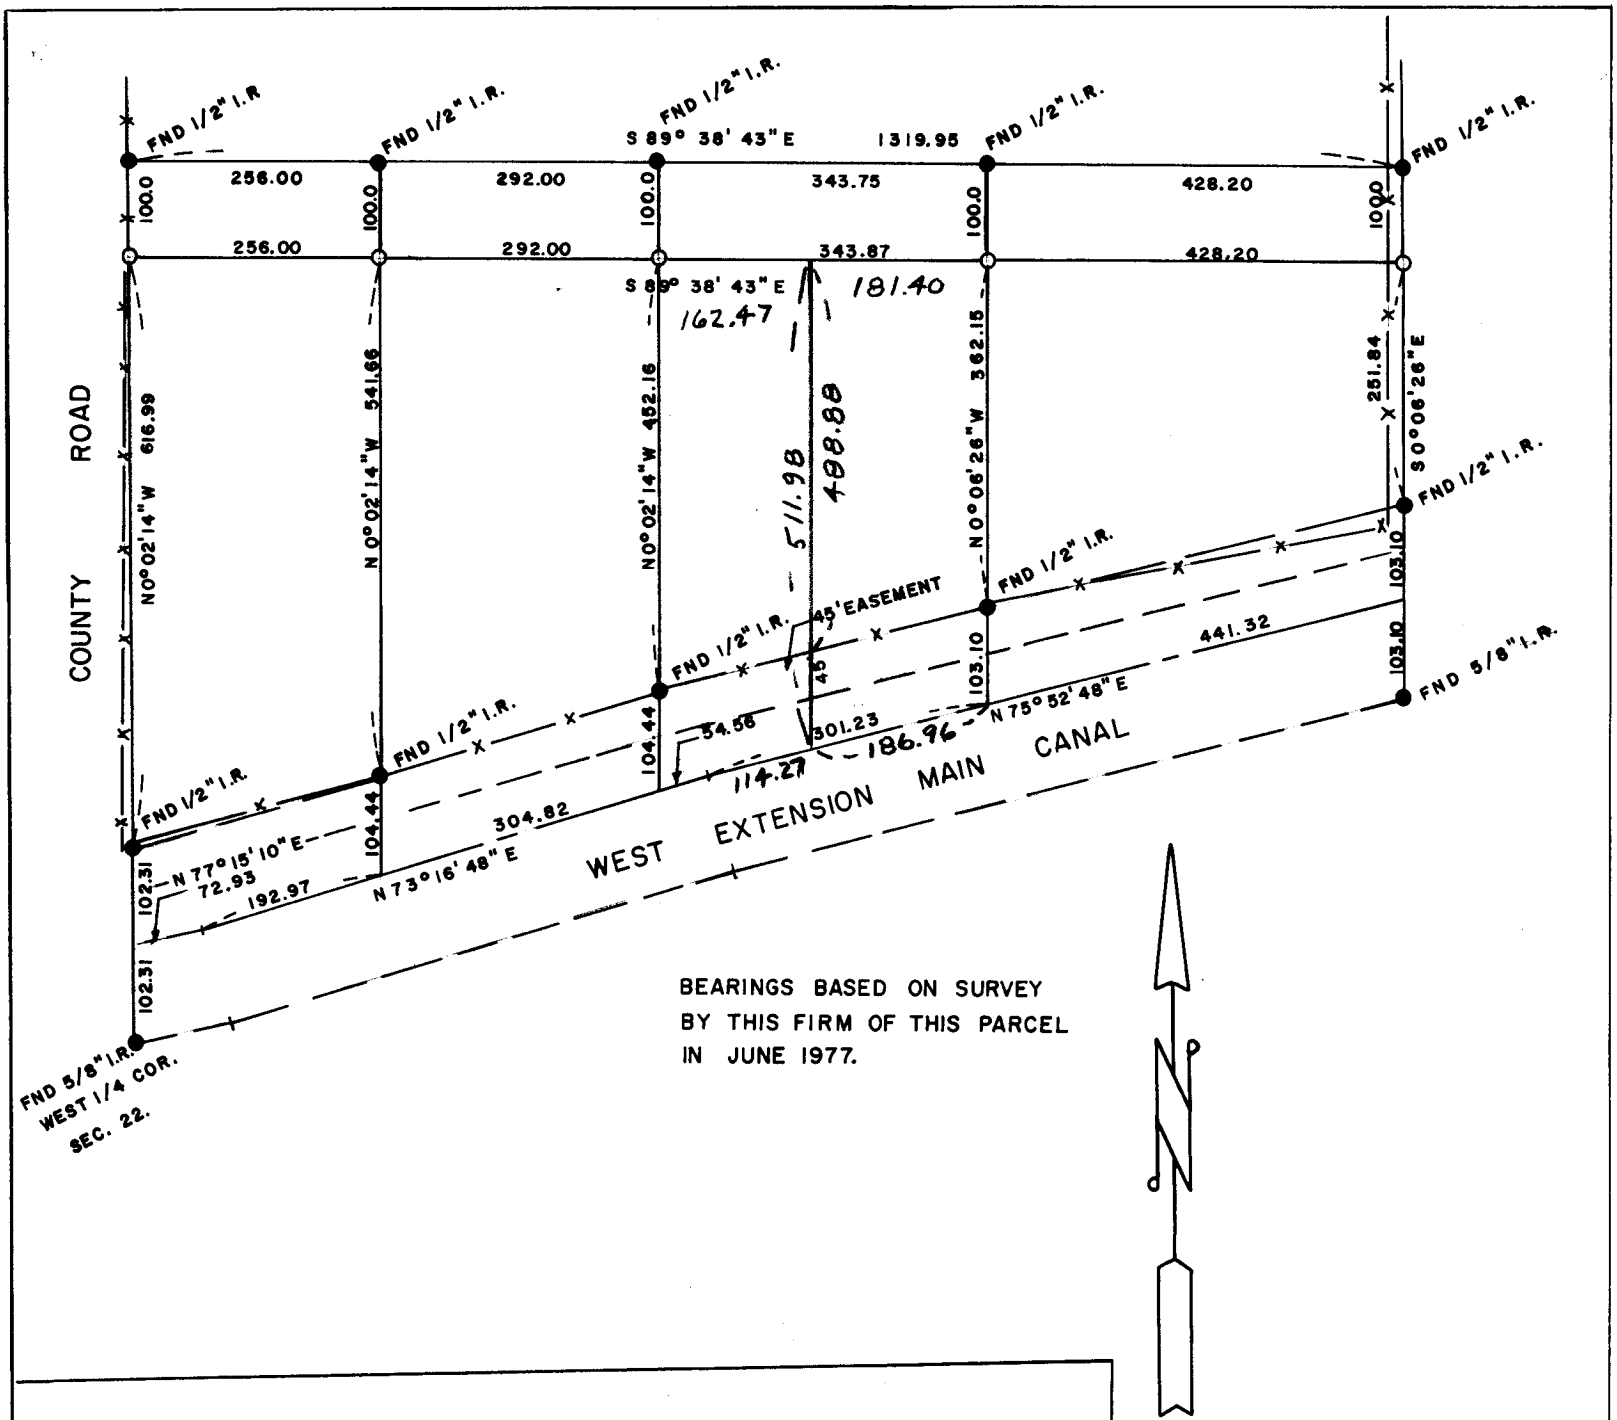

BEARINGS BASED ON SURVEY BY THIS FIRM OF THIS PARCEL IN JUNE 1977.

SURVEY FOR MAX JONES

LOCATION SW 1/4 OF NW 1/4

SEC. 22, T 5 N, R 27 E, W.M., UMATILLA COUNTY, OREGON

DATE 6-12-78

SCALE: 1" = 200'

●MONUMENTS FOUND

(000) OF RECORD

○IRON RODS SET 1/2"

JOB NO. S7706193-A

EDWARDS SURVEYING
567-3336

P.O. Box 763
Hermiston, Ore.

P-041-AX

REGISTERED PROFESSIONAL LAND SURVEYOR

G. Dennis Edwards

OREGON
JULY 16, 1971
G. DENNIS EDWARDS
951