1N 32-10

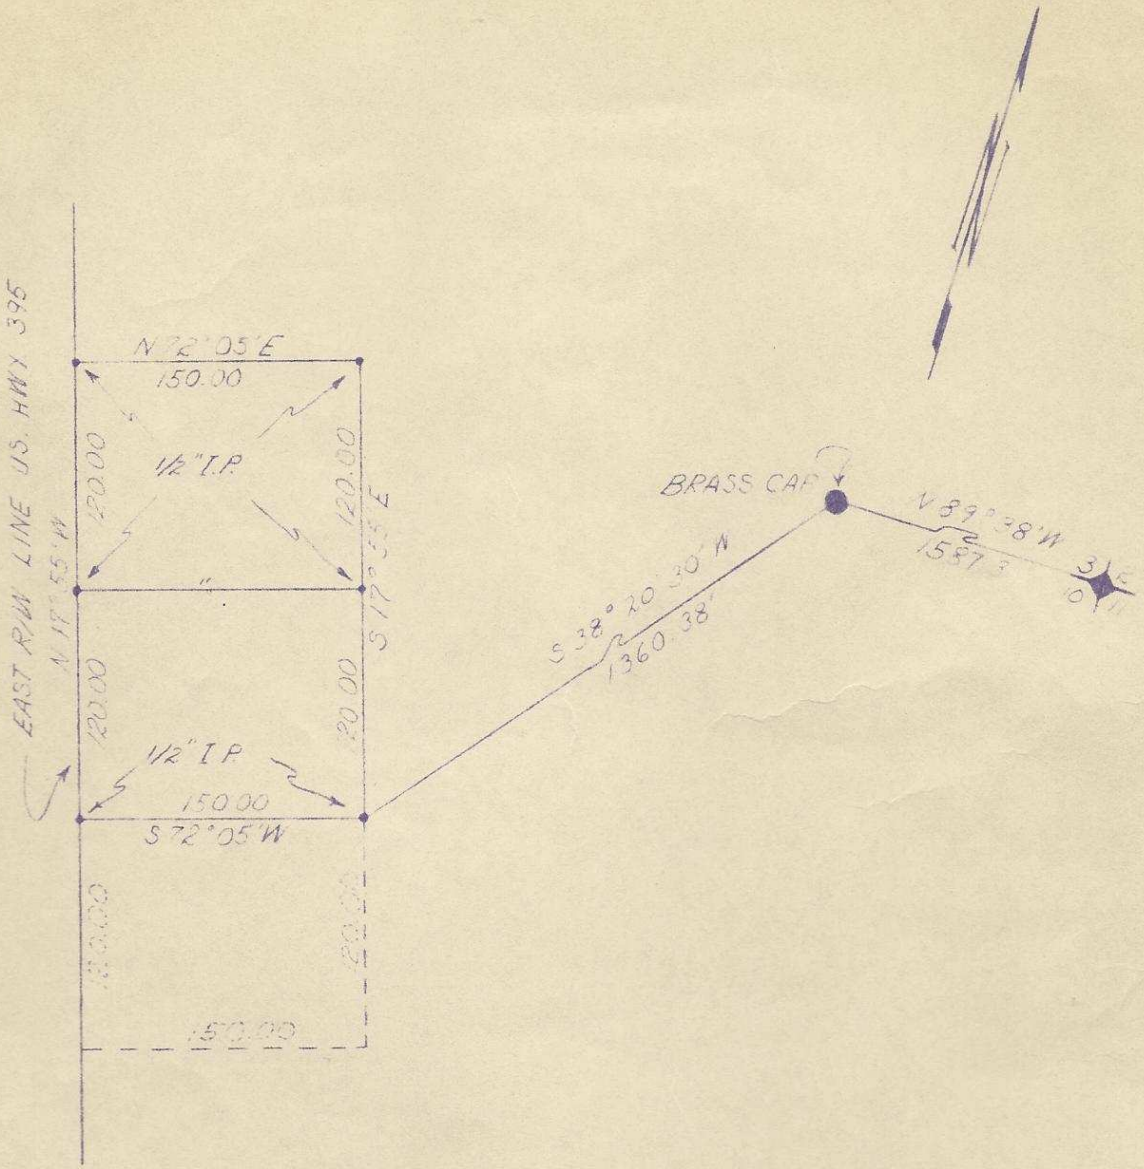

REGISTERED
OREGON
LAND SURVEYOR

Wayne G. Harris

WAYNE G. HARRIS

HAYES AND HARRIS

SURVEY FOR

L. S. WELLS

PARCELS OF LAND IN N½, N½, SEC. 10,
T. 1 N., R. 32 E., W.M.

SCALE	DATE	DRW BY	DRW NO.
1"-100'	4/10/59	RWC	59-87